

SURVEY & REMONUMENTATION

FEB 26 1998

LAND CORNER RECORDATION CERTIFICATE
Filing Requirement of Act 74, Mich. P.A. 1970

For corners in Wakeshma Township

LIBER 2 PAGE 250

Kalamazoo
(County)

Located in:

Corner Code #

1. Public Land Survey

T 4S R 9W D-03

2. Property Controlling in Section

S T R

3. Miscellaneous Property in Sec.


S T R

4. Lot No. _____, Recorded Plat _____
5. Private Claims _____

I, Robert E. Snell, in a field survey on August 1 1997 do hereby state that under requirements of P.A. 74, Michigan P.A. of 1970, the corner points mentioned in lines 1 and 2 above were in conformance with regulations and rules therefore as required in the current manual of survey instructions of the United States Department of the Interior, Bureau of Land Management or by a decree of a Court of Law and/or that the corner points mentioned in lines 3, 4 and 5 above were in conformance with the rules of the Michigan Board of Land Surveyors or by a Decree of a Court of Law, established, re-established, monumented, recovered, found as expressed below:

NOTE: Not more than 2 corners, all in the same town and range, may be recorded on this certificate.

RATIFIED
BY KALAMAZOO COUNTY
REMONUMENTATION
PEER GROUP 8-21-1997

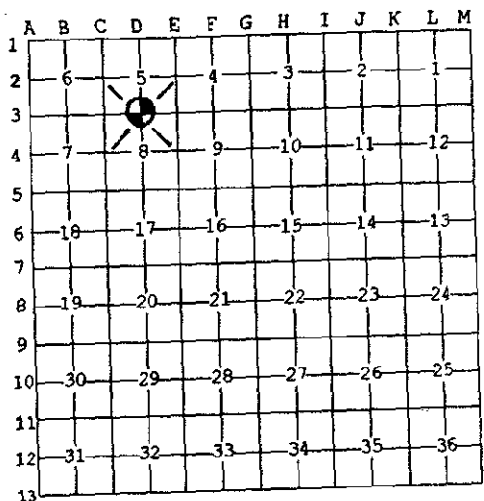

A. Description of original monument and accessories and/or subsequent restoration:

1826: United States Government Surveyors: Set 1/4 Section Post.

Sugar 11" N. 43° W. 18 1/2 lks.
Beech 24" S. 25° E. 10 lks.

1863: F. Stimson, County Surveyor: Ran North and South 1/4 line of Section 5 (not East and West 1/4 line), does not describe South 1/4 post.

1869: F. Hodgman, County Surveyor: "1/4 Section corner (South 1/4 post) witness gone, found old stake from hole of one stump by digging. Planted stone, stratified slate 18' long and marked Maple 10", N. 32° E., 97 lks., Beech 10", S. 75° W., 1.45 ch."

B. Description of corner evidence found and/or method applied in restoring or reestablishing corner:

1919: Kalamazoo County Road Commission: Witnesses only to corner.

18" Maple S. 60° E. 33.25'
18" Maple N. 70° E. 30.43'
24" Maple N. 15° W. 80.87'

1977: Wilkins & Wheaton Engineering Co.: Found and used 2 1/2' iron pipe.

1997: Found 1/2' x 12" iron over 2 1/2" x 16" iron pipe near South side of intersection of roads, noted exist nail/tab in 24" Sycamore, S. 140 E., 59.69'.

C. Description of monument for corner and accessories established to perpetuate locating the position of the corner:

D-03: South 1/4 Post, Section 5, T. 4 S., R. 9 W.: Ratified by Kalamazoo County Remonumentation Program Peer Group on August 21, 1997 and is accepted as a careful and faithful perpetuation of the position of the original corner. Found 2 1/2" iron pipe with 1/2' x 12" iron over placed by Kalamazoo County Road Commission in place of stone set by F. Hodgman, County Surveyor in 1869 survey. Removed 2 1/2' iron pipe and placed a 20" Harrison monument in its place.

P.K. nail in West Side 24" Sycamore S. 140 E. 59.10'
P.K. nail in East Side 22" Maple S. 48° W. 47.25'
P.K. nail in North Side 25" Maple S. 80° W. 55.25'
P.K. nail in South Side Power Pole N. 62° W. 79.60'

Signed by Robert E. Snell
Surveyor's Michigan License No. 9734

Date 12-16-97

Register of Deeds Stamp & File Number
97 DEC 17 AM 9 3
STATE OF MICHIGAN
COUNTY OF KALAMAZOO
RECORDED FOR RECORD