

STATE OF MICHIGAN
COUNTY OF KALAMAZOO
RECEIVED FOR RECORD

'95 AUG 31 AM 11 35

LAND CORNER RECORDATION CERTIFICATE
Filing Requirement of Act 74, Mich. P.A. 1970

For corners in
KALAMAZOO
(County)

Located In:

Corner Code #

WAKESHMA TWP.

1. Public Land Survey	T <u>4</u> R <u>9</u>	<u>D5</u>
	T _____ R _____	_____
	T _____ R _____	_____
	T _____ R _____	_____
2. Property Controlling in Section	S _____ T _____ R _____	_____
	S _____ T _____ R _____	_____
3. Miscellaneous Property in Section	S _____ T _____ R _____	_____
	S _____ T _____ R _____	_____

James J. Jones

CLERK - REGISTER


LIBER **1 1345**

Register of Deeds Stamp & File Number

4. Lot No. _____, Recorded Plat _____
5. Private Claims _____

I, GARY D. HAHN, in a field survey on MAY 1, 19 95, do hereby certify that under requirements of P.A. 74, Michigan P.A. of 1970, the corner points mentioned in lines 1 and 2 above were in conformance with regulations and rules therefore as required in the current manual of survey instructions of the United States Department of the Interior, Bureau of Land Management or by a decree of a Court of Law and/or that the corner points mentioned in lines 3, 4 and 5 above were in conformance with the rules of the Michigan Board of Professional Surveyors or by a Decree of a Court of Law; established, re-established, monumented, re-monumented, recovered, found as expressed below:

NOTE: Not more than 4 corners, all in the same town and range, may be recorded on this certificate.

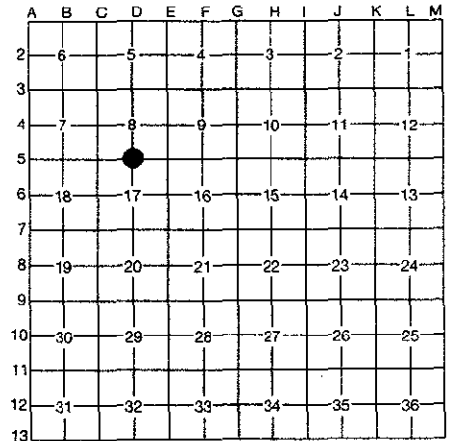

A. Description of original monument and accessories and/or subsequent restoration:

1826 Quarter section corner established by U.S. Deputy Surveyor Robert Clark, Jr.
Accessories: Beech 8 in S85°E 28½ lks.
Beech 10 in N28°W 25 lks.
1866 E. Stimson Co. Surveyor Vol. 1 Pages 54 & 55 Notes are hard to read... May call for "Set stone and stake under & broken earthen".

Date ? KCRC notes: Iron rod Maple 18" N45°W 47.2'
Elm 10" N40°E 63.8'

B. Description of corner evidence found and/or method applied in restoring or reestablishing corner:

Original corner and accessories not recovered.
Found 3/4" dia. X 18" long rod 18" below surface of road under a rotting cut stake. Dug a 3.5' X 6' wide hole 6' deep through dirt and gravel, Hit sand at 8'. Probed 3' -4' further. Found no evidence of any other type of monument.

**RATIFIED
BY KALAMAZOO COUNTY
REMONUMENTATION
PEER GROUP
6-15-95**



C. Description of monument for corner and accessories established to perpetuate locating the position of the corner:

D5, South-quarter corner section 8, T4S, R9W, Ratified by Kalamazoo County Remonumentation Peer Group on June 15, 1995. Location of 3/4" dia. rod is accepted as the best available evidence of the position of the original corner. Removed 3/4" dia. rod and replaced with a 30" Harrison Monument in box.

- Set P.K. nail in 5" Maple S26°E 34.31'
- Set P.K. nail in 6" Maple South 27.85'
- Set P.K. nail in 5" Maple S39°W 35.17'
- Set P.K. nail in P.P. N20°W 74.61'

Signed by *Gary D. Hahn*

Date August 19, 1995

Surveyor's Michigan License No. 38116