

**SURVEY &
REMONUMENTATION**

FEB 26 1998

1-405 SECTION

LAND CORNER RECORDATION CERTIFICATE
Filing Requirement of Act 74, Mich. P.A. 1970


LIBER 2PAGE 249
 STATE OF MICHIGAN
 COUNTY OF KALAMAZOO
 RECEIVED FOR RECORD
 97 DEC 17 AM 9 30
 Clerk - Register
 Register of Deeds Stamp & File Number

For corners in Wakeshma

<u>Kalamazoo</u> (County)	Located in:	Corner Code #
1. Public Land Survey	T 4S R 9W	E-01
	T R	
	T R	
	T R	
2. Property Controlling in Section	S T R	
	S T R	
3. Miscellaneous Property in Sec.	S T R	
	S T R	

4. Lot No. _____, Recorded Plat _____
 5. Private Claims _____

I, Robert E. Snell, in a field survey on August 18, 1997 do hereby state that under requirements of P.A. 74, Michigan P.A. of 1970, the corner points mentioned in lines 1 and 2 above were in conformance with regulations and rules therefore as required in the current manual of survey instructions of the United States Department of the Interior, Bureau of Land Management or by a decree of a Court of Law and for that the corner points mentioned in lines 3, 4 and 5 above were in conformance with the rules of the Michigan Board of Land Surveyors or by a Decree of a Court of Law; established, re-established, monumented, recovered, found as expressed below.

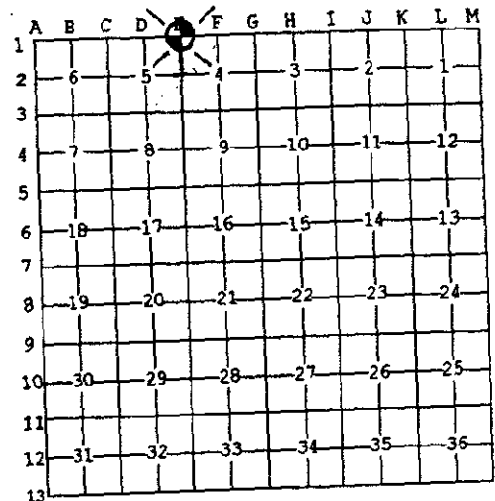

NOTE: Not more than 2 corners, all in the same town and range, may be recorded on this certificate.

- A. Description of original monument and accessories and/or subsequent restoration:
- 1826: United States Government Surveyors: Intersected North boundary 49 lks. East of post. Set post at intersection, corner to Sections 4 & 5.
 Beech 5" S. 32° E. 26 lks.
 White Ash 6" S. 55° W. 38½ lks.
 - 1883: F. Hodgman, County Surveyor: (Southeast corner Section 32, Climax Township) found stake hole by measuring from one U.S. bearing tree and from corner post of Sections 4 & 5, Wakeshma. ... corner Sections 4 & 5, East 49 lks. set 1 ft. earthen post.

- B. Description of corner evidence found and/or method applied in restoring or reestablishing corner:
- 1997: Found 3" round tile with "x" on top on South bank of Hendrixson Drain about 2" above surface.

RATIFIED
BY KALAMAZOO COUNTY
REMONUMENTATION
PEER GROUP
 9-18-1997

- C. Description of monument for corner and accessories established to perpetuate locating the position of the corner:
- E-01: Northwest corner, Section 4, T. 4 S., R. 9 W., ratified by the Kalamazoo County Remonumentation Program Peer Group on September 18, 1997, and is accepted as a careful and faithful perpetuation of the position of the original corner. Found 3" round tile with "x" on top as set in 1883 remonumentation survey. Placed remonumentation sleeve over tile.
- | | | | |
|-------------------------------|------------|-----------|--------|
| PK Nail in South Side | 6" Hickory | East | 27.93' |
| PK Nail in West Side | 14" Ash | S. 30° E. | 4.16' |
| PK Nail in North Side | 11" Elm | S. 56° W. | 5.22' |
| "x" in remonumentation sleeve | | N. 80° W. | 32.28' |

Signed by Robert E. Snell
 Surveyor's Michigan License No. 9734

Date 12-17-97