

**SURVEY & REMONUMENTATION**

FEB 26 1998

LIBER 2 PAGE 217

**SECTION**

**LAND CORNER RECORDATION CERTIFICATE**  
Filing Requirement of Act 74, Mich. P.A. 1970

For corners in Wakeshma Township


STATE OF MICHIGAN  
COUNTY OF KALAMAZOO  
RECEIVED FOR RECORD  
97 OCT 22 AM 10 41  
*Janice Johnson*  
CLERK - REGISTER

Kalamazoo (County)	Located In:	Corner Code #
1. Public Land Survey	T 4S R 9W	E-03
	T R	
	T R	
	T R	
2. Property Controlling in Section	S T R	
	S T R	
3. Miscellaneous Property in Sec.	S T R	
	S T R	

Register of Deeds Stamp & File Number

4. Lot No. \_\_\_\_\_, Recorded Plat \_\_\_\_\_  
5. Private Claims \_\_\_\_\_

I, Robert E. Snell, in a field survey on July 23, 1997 do hereby state that under requirements of P.A. 74, Michigan P.A. of 1970, the corner points mentioned in lines 1 and 2 above were in conformance with regulations and rules therefore as required in the current manual of survey instructions of the United States Department of the Interior, Bureau of Land Management or by a decree of a Court of Law and/or that the corner points mentioned in lines 3, 4 and 5 above were in conformance with the rules of the Michigan Board of Land Surveyors or by a Decree of a Court of Law, established, re-established, monumented, recovered, found as expressed below.

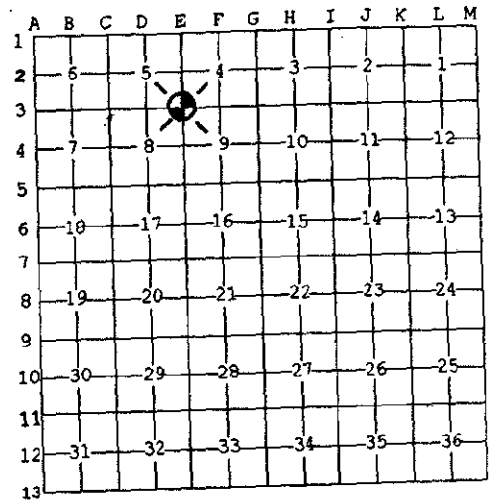

NOTE: Not more than 2 corners, all in the same town and range, may be recorded on this certificate.

**RATIFIED**  
*R.E.* BY KALAMAZOO COUNTY  
**REMONUMENTATION**  
PEER GROUP 8-21-1997

**A. Description of original monument and accessories and/or subsequent restoration:**

- 1826: United States Government Surveyors; set post, corner to Sections 4, 5, 8 & 9.  
Elm 12" N. 77° E. 18 lks.  
Black Ash 10" S. 79° W. 5½ lks.
- 1885: F. Hodgman, County Surveyor; "3(S.E. corner, Section 5) set post S. 77° W., 18 lks. from stump of Elm bearing tree, Wh. Ash 20", N. 03° W. 37 lks.

**B. Description of corner evidence found and/or method applied in restoring or reestablishing corner:**

- 1976: Wilkins & Wheaton Engineering Co., Inc., R.E. Snell, #9734; L.C.R.C., L-1, P-672, found stone  
P.P. N. 150° W., 65.5', Triple 49' Ash (maple), N. 10° E. 27.0' Double 36" Ash (maple) S. 45° E. 29.2', Iron North 2.10'.
- 1997: Found green stone (7"x4"x14") on end with stones around. Down about 4". Also found remains of wood stake along side stone.  
P.K. nail in East side (existing) P.P. N. 10° W. 65.42'

**C. Description of monument for corner and accessories established to perpetuate locating the position of the corner:**

E-03: Southwest corner, Section 4, T. 4 S., R. 9 W., ratified by the KCRPPG on August 21, 1997 and is accepted as the best available evidence. Found stone with stones around in original soil. Removed middle stone and set 20" Harrison monument to 3" below gravel road.

P.K. nail in West side	48" Triple Maple	N. 20° E.	26.79'
P.K. nail in West side	14" Ash	N. 60° E.	63.58'
P.K. nail in North side	30" Double Maple	S. 56° E.	28.11'
P.K. nail in East side	14" Ash	N. 50° W.	57.38'

Signed by Robert E. Snell  
Surveyor's Michigan License No. 9734

Date Oct. 22, 1997