



LC-000054

Page: 1 of 1  
10/29/1999 03:52P  
BK-2 Pg-507

PREIN & NEUHOFF

LANDCOR-Kalamazoo

LAND CORNER RECORDATION CERTIFICATE  
Filing Requirement of Act 74, Mich. P.A. 1970

For corners in Wakeshma Twp.

Kalamazoo  
(County)

Located in:

Corner Code #

1. Public Land Survey

T 4 S R 9 W

G-05

2. Property Controlling  
in Section

S

T R

3. Miscellaneous  
Property in Sec.

S

T R

S

T R

4. Lot No. \_\_\_\_\_ Recorded Plat  
5. Private Claims

SURVEY &  
REMONUMENTATION


FEB 08 2000

SECTION

Register of Deeds Stamp & File Number

I, Robert E. Snell, in a field survey on June 7, 1999 do hereby state that under requirements of P.A. 74, Michigan P.A. of 1970, the corner points mentioned in lines 1 and 2 above were in conformance with regulations and rules therefore as required in the current manual of survey instructions of the United States Department of the Interior, Bureau of Land Management or by a decree of a Court of Law and/or that the corner points mentioned in lines 3, 4 and 5 above were in conformance with the rules of the Michigan Board of Land Surveyors or by a Decree of a Court of Law; established, re-established, monumented, recovered, found as expressed below:

NOTE: Not more than 2 corners, all in the same town and range, may be recorded on this certificate.

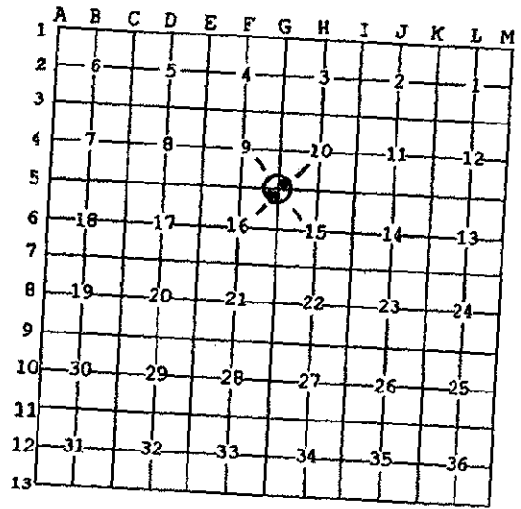

A. Description of original monument and accessories and/or subsequent restoration:

1826: United States Government Surveyors, R. Clark; set post, corner to Sections 9, 10, 15 & 16.

Sugar 13" S. 38° E. 27 1/2 lks.  
Sugar 13" West 6 lks.

1883: F. Hodgman, County Surveyor; rock bounds by R. Nutting.

B. Description of corner evidence found and/or method applied in restoring or reestablishing corner:

1999: Found 1/2" iron down 4 inches in monument box. Iron set in drill hole of large stone down 1.7'.

RATIFIED  
BY KALAMAZOO COUNTY  
REMONUMENTATION  
PEER GROUP  
9-9-1999

C. Description of monument for corner and accessories established to perpetuate locating the position of the corner:

G-05: Southeast corner, Section 9, T. 4 S., R. 9 W., ratified by the Kalamazoo County Remonumentation Program Peer Group on September 9, 1999 and is accepted as the best available evidence of the position of the original corner. Found 1/2" x 12" iron in monument box over drilled stone. Stone believed to be "rock bounds" set by R. Nutting, Surveyor and used in 1883 survey by F. Hodgman, County Surveyor. Placed 10" or 20" Harrison monument over drilled stone with monument box over.

PK Nail in South Side Power Pole N. 70° E. 73.64'  
PK Nail in East Side 18" Walnut S. 36° W. 60.87'  
PK Nail in North Side 16" Walnut S. 56° W. 54.06'  
PK Nail in North Side Power Pole N. 50° W. 54.42'

Signed by Robert E. Snell  
Surveyor's Michigan License No. 9734

Date 10/25/99