



LC-000053
Page: 1 of 1
10/29/1999 03:52P
Bk-2 Pg-506

LAND CORNER RECORDATION CERTIFICATE
Filing Requirement of Act 74, Mich. P.A. 1970

SURVEY &
REMONUMENTATION

For corners in Wakeshma Twp.

FEB 08 2000

SECTION


<u>Kalamazoo</u> (County)	Located in:	Corner Code #
1. Public Land Survey	T 4 S R 9 W	L-09
	T _____ R _____	_____
	T _____ R _____	_____
	T _____ R _____	_____
2. Property Controlling in Section	S _____ T _____ R _____	_____
	S _____ T _____ R _____	_____
3. Miscellaneous Property in Sec.	S _____ T _____ R _____	_____
	S _____ T _____ R _____	_____

Register of Deeds Stamp & File Number

- 4. Lot No. _____, Recorded Plat _____
- 5. Private Claims _____

I, Robert E. Snell, in a field survey on June 10, 1999 do hereby state that under requirements of P.A. 74, Michigan P.A. of 1970, the corner points mentioned in lines 1 and 2 above were in conformance with regulations and rules therefore as required in the current manual of survey instructions of the United States Department of the Interior, Bureau of Land Management or by a decree of a Court of Law and/or that the corner points mentioned in lines 3, 4 and 5 above were in conformance with the rules of the Michigan Board of Land Surveyors or by a Decree of a Court of Law; established, re-established, monumented, recovered, found as expressed below:

NOTE: Not more than 2 corners, all in the same town and range, may be recorded on this certificate.

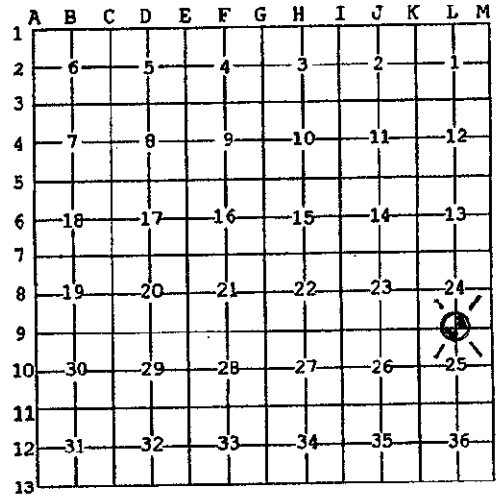

A. Description of original monument and accessories and/or subsequent restoration:

1826: United States Government Surveyors, R. Clark; set 1/4 Section post.

Beech 10"	S. 24° E.	33 1/2 lks.
Beech 8"	North	3 lks.

Note: Could not find any historical record of this corner.

RATIFIED
BY KALAMAZOO COUNTY
REMONUMENTATION
PEER GROUP
9-9-1999

B. Description of corner evidence found and/or method applied in restoring or reestablishing corner:

1999: Dug a hole 5' deep and found large stone 12" x 12" x 18" with 5/8" drill hole. Also found iron pin about 3.1' East of stone. Pin was 3' below surface. Pin believed to be the intersection of center lines.

Noted:	Center line North End	Concrete Culvert	Northwesterly	45.82'
	Center line South End	Concrete Culvert	Southwesterly	43.40'

C. Description of monument for corner and accessories established to perpetuate locating the position of the corner:

L-09: South 1/4 post, Section 24, T. 4 S., R. 9 W., ratified by the Kalamazoo County Remonumentation Program Peer Group on September 9, 1999 and is accepted as the best available evidence of the position of the original corner. Found 12" x 12" x 18" Stone with drill hole believed to be a "rock bound" by R. Nutting, Surveyor, date unknown. Placed 20" Harrison monument in Monument box over drill hole in stone.

Exist. Nail in West Side	36" Walnut	N. 40° E.	64.15'
Exist. Nail in North Side	Power Pole	S. 62° E.	70.83'
Exist. Nail in North Side	Power Pole	S. 48° W.	42.28'
Exist. Nail in South Side	28" Walnut	N. 44° W.	46.10'

Signed by Robert E. Snell
Surveyor's Michigan License No. 9734

Date 10/25/1999