

LAND CORNER RECORDATION CERTIFICATE
Filing Requirement of Act 74, Mich. P.A. 1970

STATE OF MICHIGAN
COUNTY OF KALAMAZOO
RECEIVED FOR RECORD
98 OCT 12 PM 1 28
J. H. ...
CLERK - REGISTER

For corners in Brady Township
Kalamazoo
(County)

Table with columns: Located In, Corner Code #, and rows for Public Land Survey, Property Controlling in Section, Miscellaneous Property in Section.

Register of Deeds Stamp & File Number

4. Lot No. , Recorded Plat
5. Private Claims

IWM Job No. 28528-95

Grid table with columns A-M and rows 2-13. Cell (10, A) contains '30'.

I, Allen H. McMachen, in a field survey on January 9, 1998 do hereby certify that under requirements of P.A. 74, Michigan P.A. of 1970, the corner points mentioned in lines 1 and 2 above were in conformance with regulations and rules therefore as required in the current manual of survey instructions of the United States Department of the Interior, Bureau of Land Management or by a decree of a Court of Law and/or that the corner points mentioned in lines 3, 4 and 5 above were in conformance with the rules of the Michigan Board of Professional Surveyors or by a Decree of a Court of Law; established, re-established, monumented, re-monumented, recovered, found as expressed below:

NOTE: Not more than 4 corners, all in the same town and range, may be recorded on this certificate.

A. Description of original monument and accessories and/or subsequent restoration:

Corner not placed by original government surveyors
1869 - F. Hodgman, C.S., "Center of Section established at intersection of 1/4 lines N. & S. - E. & W. Set stake with brick around from which W. Oak 22" S. 88° E. 67 lks., W. Oak 20" N. 09° E. 101 lks. Measured S. 1/4 cor. to Center 1/4 cor. at 2642.64'. Measured W. 1/4 cor. to Center 1/4 cor. at 2821.17'."
1872 - S. Hodgman, D.C.S., "Set new stake for intersection of 1/4 lines 2 1/2 lks. North of erroneous one and marked W. Oak 24" S. 71° E. 7 1/2 lks., Wh. Oak 20" N. 33° E. 57 1/2 lks.. Measured from S. 1/4 cor. North 2656.83' to Center 1/4 cor.'"
1957 - W.D. Ingersoll, R.L.S., "Found a large stone with a pointed top" shown to field crew by John Shick the current land owner. Obtained affidavit from Mr. Shick stating: "The Center of Sec. 30, T. 4 S., R. 10 W., is a large stone w/a pointed top which was located in original position called for in S.C. Hodgman's notes. The original corner placed by Hodgman was replaced w/above stone by an early settler of this land named Jerome Clark Mr. Clark informed present landowner, Mr. John Shick, that said 'stone' was in exact location as original corner. Above information was related to me (John Stack) Sept. 30, 1957, by Mr. John Shick." No wits. were taken.

B. Description of corner evidence found and/or method applied in restoring or reestablishing corner:

Found stone with drill hole. Measured West 2835.53' to W. 1/4 cor., measured South 2668.60 feet to S. 1/4 cor. and measured North 2670.43 feet to N. 1/4 cor.. Found stone is 2.54 feet West of a straight line between the N. 1/4 cor. and the S. 1/4 cor. above 1/2 miles measured prorate to S. Hodgman's & F. Hodgman's measures very well.


SURVEY &
REMONUMENTATION
NOV 25 1998
SECTION

RATIFIED
BY KALAMAZOO COUNTY
REMONUMENTATION
PEER GROUP
2/19/98
R. J. ...

C. Description of monument for corner and accessories established to perpetuate locating the position of the corner:

Found stone with drill hole is accepted as the best available evidence of the position of the corner. Turned stone on its side in hole and placed 30" Harrison Monument over original drill hole location, Accessories:

- Nail in SW side of Triple 12" Cherry N. 35° W. 12.47'
Nail in SE side of Twin 16" Elm N. 53° E. 122.05'
Nail in SW side of Twin 18" Elm S. 45° E. 126.85'
2' West of fence to North & 6' South of fence to East
Placed iron rod S. 85° E. 44.5'

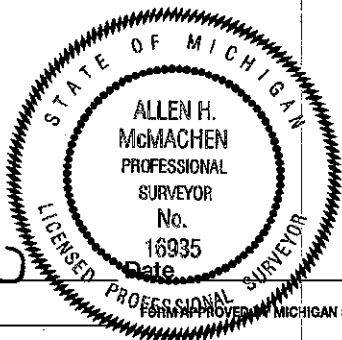

Signed by [Signature]
Surveyor's Michigan License No. 16935

7/14/98