

**SURVEY & REMONUMENTATION**

9- MAY 28 1997  
2- COMMISSION

LIBER 2 PAGE 109

**LAND CORNER RECORDATION CERTIFICATE**  
Filing Requirement of Act 74, Mich. P.A. 1970

For corners in

<u>Kalamazoo</u> (County)	Located In:	Corner Code #
Brady Twp.		
1. Public Land Survey	T <u>4S</u> R <u>10W</u>	<u>D8</u>
	T _____ R _____	_____
	T _____ R _____	_____
	T _____ R _____	_____
2. Property Controlling in Section	S _____ T _____ R _____	_____
	S _____ T _____ R _____	_____
3. Miscellaneous	S _____ T _____ R _____	_____
Property in Sec.	S _____ T _____ R _____	_____

STATE OF MICHIGAN  
COUNTY OF KALAMAZOO  
RECEIVED FOR RECORD  
96 DEC 31 PM 3 22  
OF REC-REGISTER  
*[Signature]*  
Register of Deeds Stamp & File Number

4. Lot No. \_\_\_\_\_, Recorded Plat \_\_\_\_\_  
5. Private Claims \_\_\_\_\_

I, Gary D. Hahn, in a field survey on May 3, 19 96 do hereby state that under requirements of P.A. 74, Michigan P.A. of 1970, the corner points mentioned in lines 1 and 2 above were in conformance with regulations and rules therefore as required in the current manual of survey instructions of the United States Department of the Interior, Bureau of Land Management or by a decree of a Court of Law and/or that the corner points mentioned in lines 3, 4 and 5 above were in conformance with the rules of the Michigan Board of Land Surveyors or by a Decree of a Court of Law; established, re-established, monumented, recovered, found as expressed below:

**NOTE: Not more than 2 corners, all in the same town and range, may be recorded on this certificate.**

A	B	C	D	E	F	G	H	I	J	K	L	M
1												
2	6		5		4		3		2		1	
3												
4	7		8		9		10		11		12	
5												
6	18		17		16		15		14		13	
7												
8	19		●		21		22		23		24	
9												
10	30		29		28		27		26		25	
11												
12	31		32		33		34		35		36	
13												

A. Description of original monument and accessories and/or subsequent restoration:

This corner not established during original G.L.O. survey.


1919 Kalamazoo County Road Commission plans for 27th Street call for an iron rod as the center of section 2652.7' south of the north quarter post and 2653.4' north of the south quarter post of section 20.

Witness Ties: Oak 18" South 45 degrees West 32.4'  
Maple 10" South 20 degrees East 87.9'  
Apple 14" North 45 degrees East 33.0'  
R.R. iron fence cor. East 25.8'

B. Description of corner evidence found and/or method applied in restoring or reestablishing corner:

Found 1/2" rebar in monument box 1.5' +/- west of centerline of 27th Street. Dug a 3' X 6' X 3' deep hole and probed an additional 4' into sand. Found no additional monument evidence. Road does not appear to have been extensively filled. Measured distance to south quarter post (2653.59) fits KCRC 1919 distance reasonably well. Two witness ties match KCRC 1919 witness ties reasonably well.

**RATIFIED**  
**BY KALAMAZOO COUNTY**  
**REMONUMENTATION**  
**PEER GROUP**  
9-19-1996

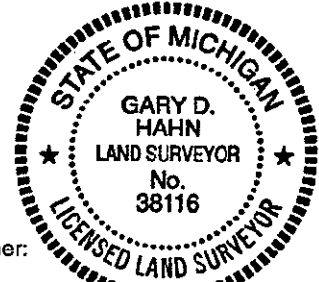

C. Description of monument for corner and accessories established to perpetuate locating the position of the corner:

D8, Center of Section 20, Town 4 South, Range 10 West, ratified by Kalamazoo County Remonumentation Peer Group on September 19, 1996. Found 1/2" rebar in mon. box believed to be in same position as KCRC 1919 iron rod. This position not established by original government surveyors. The 1/2" rebar is accepted as a careful and faithful perpetuation of the KCRC 1919 corner. Removed rebar and set a 20" Harrison Monument in mon. box

Fnd. P.K. Nail in P.P. South 89 degrees East 50.11  
Fnd. nail in 36" Maple South 14 degrees East 87.42'  
Set P.K. nail in P.P. North 80 degrees West 24.29'  
Set 1/2" rebar North 20 degrees East 56.47'  
R.R. iron fence post East 26.0'

Harrison Monument (N 1/4 post) North 2656.28'  
Harrison Monument (S 1/4 post) South 2653.59'

Signed by *[Signature]*  
Surveyor's Michigan License No. 38116

Date 12/27/96