

SURVEY & REMONUMENTATION

3- MAY 28 1997
COMMISSION

LAND CORNER RECORDATION CERTIFICATE
Filing Requirement of Act 74, Mich. P.A. 1970

LIBER 2PAGE 110

For corners in

<u>Kalamazoo</u> (County)	Located In:	Corner Code #
Brady Twp.		
1. Public Land Survey	T <u>4S</u> R <u>10W</u>	<u>D10</u>
	T _____ R _____	_____
	T _____ R _____	_____
	T _____ R _____	_____
2. Property Controlling in Section	S _____ T _____ R _____	_____
	S _____ T _____ R _____	_____
3. Miscellaneous Property in Sec.	S _____ T _____ R _____	_____
	S _____ T _____ R _____	_____

STATE OF MICHIGAN
COUNTY OF KALAMAZOO
RECEIVED FOR RECORD
'96 DEC 31 PM 3 22
Register of Deeds Stamp & File Number

CLERK-REGISTER
[Signature]

4. Lot No. _____, Recorded Plat _____
5. Private Claims _____

I, Gary D. Hahn, in a field survey on May 2, 1996 do hereby state that under requirements of P.A. 74, Michigan P.A. of 1970, the corner points mentioned in lines 1 and 2 above were in conformance with regulations and rules therefore as required in the current manual of survey instructions of the United States Department of the Interior, Bureau of Land Management or by a decree of a Court of Law and /or that the corner points mentioned in lines 3, 4 and 5 above were in conformance with the rules of the Michigan Board of Land Surveyors or by a Decree of a Court of Law; established, re-established, monumented, recovered, found as expressed below:

NOTE: Not more than 2 corners, all in the same town and range, may be recorded on this certificate.

A	B	C	D	E	F	G	H	I	J	K	L	M
1												
2	6		5		4		3		2		1	
3												
4	7		8		9		10		11		12	
5												
6	18		17		16		15		14		13	
7												
8	19		20		21		22		23		24	
9												
10	30		●		28		27		26		25	
11												
12	31		32		33		34		35		36	
13												


A. Description of original monument and accessories and/or subsequent restoration:

This corner not established during G.L.O. original survey.
1880 F.Hodgman: "Bisected North & South quarter cor. - set stone with side stones 50 links East & West."
1919 KCRC plans for 27th Street give a distance of 2655.9' to North quarter post Sec. 29 and 2658.2' to South quarter post Sec. 29.

B. Description of corner evidence found and/or method applied in restoring or reestablishing corner:

Found 3/4" dia. X 24" long rod in pavement. Dug a 5' X 9' X 4' deep hole around rod into sand. Found a 14" X 14" X 4" stone flat side up a distance of 2.5' South and 3.0' West of rod. Stone was unremarkable. But only stone found. Probed 3' below stone. Found no additional monument evidence. Fnd. side stone 34.1' East of stone. Distance from stone to North quarter post Sec. 29 is 2654.12'. Distance from stone to South quarter post Sec. 29 is 2660.25 feet.

RATIFIED
BY KALAMAZOO COUNTY
REMONUMENTATION
PEER GROUP
12-19-1996

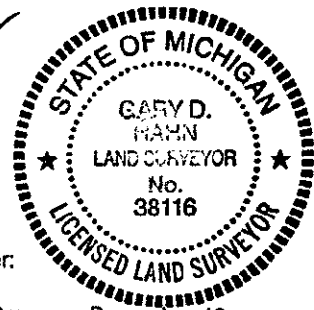

C. Description of monument for corner and accessories established to perpetuate locating the position of the corner:

D10, Center of Section 29, Town 4 South, Range 10 West, ratified by Kalamazoo County Remonumentation Peer Group on December 19, 1996. The 14" X 14" X 4" stone believed to be same as set by F. Hodgman in 1880. This position not established by original government surveyors. The position of the stone is accepted as the best available evidence of the position of the corner. Set a 20" Harrison Monument over stone in a mon. box.
Set P.K. nail in 36" Walnut South 20 degrees West 68.30'
Set P.K. nail in Dead Tree South 75 degrees West 19.59'
Set P.K. nail in 24" Walnut North 35 degrees West 67.97'
Set P.K. nail in 8" Pine South 79 degrees East 28.12'

Signed by *[Signature]*
Surveyor's Michigan License No. 38116

Date 12/28/96