SURVEY &
REMONUMENTATION

1
2

APR 27 1995

COMMISSION **LAND CORNER RECORDATION CERTIFICATE**

Filing Requirement of Act 74, Mich. P.A. 1970

STATE OF MICHIGAN
COUNTY OF KALAMAZOO
RECEIVED FOR RECORD
'94 DEC 30 AM 9 18
CLERK-REGISTER

LIBER 1 PG 1235

Register of Deeds Stamp & File Number

For corners in

Kalamazoo
(County)

Brady Township

	Located In:	Corner Code #
1. Public Land Survey	T 4 S R 10 W	D-11
	T ___ R ___	
	T ___ R ___	
	T ___ R ___	
2. Property Controlling	S ___ T ___ R ___	
in Section	S ___ T ___ R ___	
3. Miscellaneous	S ___ T ___ R ___	
Property in Sec.	S ___ T ___ R ___	

4. Lot No. _____, Recorded Plat _____
5. Private Claims _____

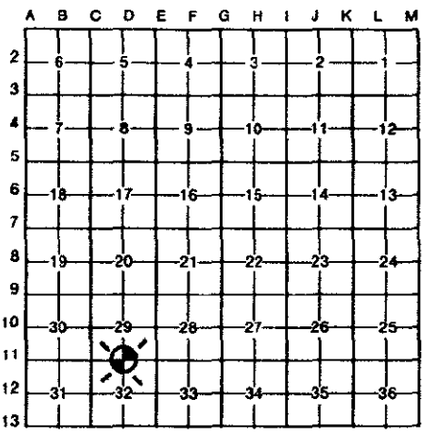

I, Robert E. Snell, in a field survey on June 6, 19 94, do hereby certify that under requirements of P.A. 74, Michigan P.A. of 1970, the corner points mentioned in lines 1 and 2 above were in conformance with regulations and rules therefore as required in the current manual of survey instructions of the United States Department of the Interior, Bureau of Land Management or by a decree of a Court of Law and/or that the corner points mentioned in lines 3, 4 and 5 above were in conformance with the rules of the Michigan Board of Land Surveyors or by a Decree of a Court of Law; established, re-established, monumented, re-monumented, recovered, found as expressed below:

NOTE: Not more than 4 corners, all in the same town and range, may be recorded on this certificate.

A. Description of original monument and accessories and/or subsequent restoration:

1826: U.S. Government Survey; Set 1/4 Section Post.

W. Oak	12"	South	07°	West	44 Lks
W. Oak	19"	North	82°	East	61 Lks

1863: F. Stimson; Notes obliterated.

1879: F. Hodgman, County Surveyor; Corner from former survey.

1912: E. Strong, County Surveyor; Stone.

W. Oak 13" South 40° East 76 Lks Corner Post Southwest 63 Lks

B. Description of corner evidence found and/or method applied in restoring or reestablishing corner:

1994: Found stone and bricks and a tier of smaller stones with outline of stake below larger stones. A PK nail was found 8.7' North and 2.4' West of stone. Another PK nail was found 2' West and 1' South of PK nail just mentioned. A large area was excavated that included beneath both PK Nails mentioned above. A 1919 copy of Kalamazoo County Road Commisson noted an iron rod at corner but did not find.

RATIFIED
BY KALAMAZOO COUNTY
REMONUMENTATION
PEER GROUP
9-15-94

C. Description of monument for corner and accessories established to perpetuate locating the position of the corner:

D-11 South 1/4 Post Section 29, T. 4 S., R. 10 W., Ratified by the Kalamazoo County Remonumentation Program Peer Group on September 15, 1994. Found bricks and stone, called for in 1912 survey by E. Strong and is accepted as a careful and faithful perpetuation of the position of the original corner. Removed stone and placed 20" Harrison monument through the tier of stones and placed a monument box over.

Center Line 27th Street		West			3.7'
Center Line "XY" Avenue		North			3.7'
Notch in Top	Railroad Rail Fence Corner	North	50°	West	44.40'
PK Nail in South Side	Telephone Pole Fence Corner	North	56°	East	33.95'
PK Nail in West Side	42" Maple	North	22°	West	67.86'
PK Nail in South Side	14" Maple	North	80°	East	120.82'

Signed by Robert E. Snell Date 12/28/94

Surveyor's Michigan License No. 9734

FORM APPROVED BY MICHIGAN STATE BOARD OF LAND SURVEYORS, JAN. 28, 1971
REVISED MAY 14, 1975
REVISED JAN., 1983