

LAND CORNER RECORDATION CERTIFICATE

Filing Requirement of Act 74, Mich. P.A. 1970' 95 AUG 25 PM 3 51


For corners in Kalamazoo (County) Located In: Corner Code # Brady Township 1. Public Land Survey T 4 S R 10 W F-13 2. Property Controlling in Section S T R 3. Miscellaneous Property in Section S T R 4. Lot No. , Recorded Plat 5. Private Claims

James Youngs CLERK-REGISTER

LIBER 1 1328

Register of Deeds Stamp & File Number

I, Garth N. Baden, in a field survey on April 25, 1995, do hereby certify that under requirements of P.A. 74, Michigan P.A. of 1970, the corner points mentioned in lines 1 and 2 above were in conformance with regulations and rules therefore as required in the current manual of survey instructions of the United States Department of the Interior, Bureau of Land Management or by a decree of a Court of Law and/or that the corner points mentioned in lines 3, 4 and 5 above were in conformance with the rules of the Michigan Board of Professional Surveyors or by a Decree of a Court of Law; established, re-established, monumented, re-monumented, recovered, found as expressed below:

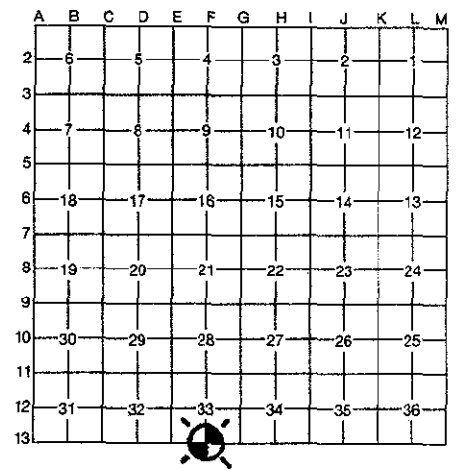

NOTE: Not more than 4 corners, all in the same town and range, may be recorded on this certificate.

A. Description of original monument and accessories and/or subsequent restoration:

1825: United States Government Survey; Set 1/4 Section Post. Wh. Oak 9" North 58° West 128 Lks Wh. Oak 16" North 35° East 162 Lks

1875: F. Hodgman, County Surveyor; Lost. Bi-sected (4-3) [Southwest Corner-Southeast Corner Section 33]. Set stake and stones.

Y. Oak 10" South 58 1/2° East 15 Lks Y. Oak 8" South 47° West 21 Lks

B. Description of corner evidence found and/or method applied in restoring or reestablishing corner:

1995: Found a pointed stone with a ring of stones around it. A fence post hole was 8.52' East with stones around it.

RATIFIED BY KALAMAZOO COUNTY REMONUMENTATION PEER GROUP 5-18-95 R.E.C.

C. Description of monument for corner and accessories established to perpetuate locating the position of the corner:

F-13 South 1/4 Post Section 33, T. 4 S., R. 10 W., Ratified by the Kalamazoo County Remonumentation Program Peer Group on May 18, 1995 and is accepted as a careful and faithful perpetuation of the position of the original corner. Found a pointed stone with a ring of stones around a stake and stones as called for by F. Hodgman in a survey in 1875. Removed pointed stone and placed a 30" Harrison monument in its place. A fence post hole with stones layered around it is 8.52' East (F-1, T. 5 S., R. 10 W.).

- PK Nail in East Side 6" Hickory South 05° West 6.97' PK Nail in East Side 26" Oak North 18° West 6.72' PK Nail in North Side 22" Poplar North 50° East 21.64' PK Nail in South Side 8" Wild Cherry South 83° West 21.88' PK Nail in West Side 24" Oak South 20° East 20.51'

Signed by [Signature] Date Aug 22, 1995

Surveyor's Michigan License No. 10679