

**SURVEY & REMONUMENTATION**

7  
2  
APR 27 1995

COMMISSION

**LAND CORNER RECORDATION CERTIFICATE**  
Filing Requirement of Act 74, Mich. P.A. 1970

For corners in

Kalamazoo Located In: \_\_\_\_\_ Corner Code # \_\_\_\_\_  
(County)

Brady Township

1. Public Land Survey T 4 S R 10 W G-12  
T \_\_\_\_\_ R \_\_\_\_\_  
T \_\_\_\_\_ R \_\_\_\_\_  
T \_\_\_\_\_ R \_\_\_\_\_

2. Property Controlling S \_\_\_\_\_ T \_\_\_\_\_ R \_\_\_\_\_  
in Section S \_\_\_\_\_ T \_\_\_\_\_ R \_\_\_\_\_

3. Miscellaneous S \_\_\_\_\_ T \_\_\_\_\_ R \_\_\_\_\_  
Property in Sec. S \_\_\_\_\_ T \_\_\_\_\_ R \_\_\_\_\_

4. Lot No. \_\_\_\_\_, Recorded Plat \_\_\_\_\_


5. Private Claims \_\_\_\_\_

STATE OF MICHIGAN  
COUNTY OF KALAMAZOO  
RECEIVED FOR RECORD  
94 DEC 30 AM 9 18  
CLERK-REGISTER

LIBER 1 PG 1238

Register of Deeds Stamp & File Number

I, Robert E. Snell, in a field survey on June 7, 19 94, do hereby certify that under requirements of P.A. 74, Michigan P.A. of 1970, the corner points mentioned in lines 1 and 2 above were in conformance with regulations and rules therefore as required in the current manual of survey instructions of the United States Department of the Interior, Bureau of Land Management or by a decree of a Court of Law and/or that the corner points mentioned in lines 3, 4 and 5 above were in conformance with the rules of the Michigan Board of Land Surveyors or by a Decree of a Court of Law, established, re-established, monumented, re-monumented, recovered, found as expressed below:

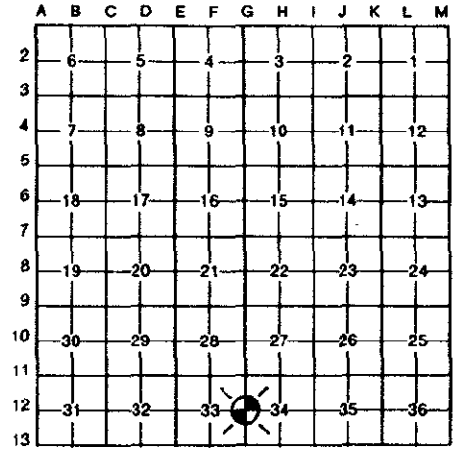

**NOTE: Not more than 4 corners, all in the same town and range, may be recorded on this certificate.**

- A. Description of original monument and accessories and/or subsequent restoration:
- 1825: U.S. Government Survey; Set 1/4 Section Post.
    - W. Oak 13" North 33 1/2° West 119 Lks
    - W. Oak 17" South 86° East 29 Lks
  - 1919: Kalamazoo County Road Commission; Stone.
    - Cherry 8" North 20° East 35'
    - Locust 15" South 80° East 95.8'

**RATIFIED**  
BY KALAMAZOO COUNTY  
REMONUMENTATION  
PEER GROUP  
9-15-94

Date Unknown: Kalamazoo County Surveyor Records;  
Northwest Corner of House Southeast 130.30' Pine South 60° East 131.00'

- B. Description of corner evidence found and/or method applied in restoring or reestablishing corner:
- 1994: Found iron (1/2" x 18") at surface. Found stone (10" x 8" x 7") rectangular stone with drill hole and other stones around, 18" below surface.

- C. Description of monument for corner and accessories established to perpetuate locating the position of the corner:
- G-12 East 1/4 Post Section 33, T. 4 S., R. 10 W., Ratified by the Kalamazoo County Remonumentation Program Peer Group on September 15, 1994. Found stone with drill hole and is accepted as a careful and faithful perpetuation of the position of the original corner. Lowered stone and placed a 20" Harrison monument and monument box over stone.
    - PK Nail in Northeast Side 22" Pine South 50° East 66.94'
    - PK Nail in East Side 16" Maple South 12° West 35.15'
    - PK Nail in West Side 10" Maple South 54° West 60.02'
    - PK Nail in South Side 18" Oak North 44° West 39.42'
    - Center Line "Y-Z" Avenue South 1.0'

Signed by Robert E. Snell Date 12/28/94  
Surveyor's Michigan License No. 9734