

LAND CORNER RECORDATION CERTIFICATE
Filing Requirement of Act 74, Mich. P.A. 1970

LIBER 2 PAGE 342
STATE OF MICHIGAN
COUNTY OF KALAMAZOO
RECEIVED FOR RECORD

'98 OCT 20 AM 11 25

Smiley Johnson


CLERK - REGISTER

Register of Deeds Stamp & File Number

<u>KALAMAZOO</u> (County)	Located In:	Corner Code #
1. Public Land Survey	T <u>4S</u> R <u>10W</u>	<u>1-3</u>
	T ___ R ___	_____
	T ___ R ___	_____
	T ___ R ___	_____
2. Property Controlling in Section	S ___ T ___ R ___	_____
	S ___ T ___ R ___	_____
3. Miscellaneous Property in Sec.	S ___ T ___ R ___	_____
	S ___ T ___ R ___	_____

4. Lot No. _____, Recorded Plat
5. Private Claims

I, WILLIAM K. CRANE, P.S., in a field survey on OCTOBER, 19 97 do hereby state that under requirements of P.A. 74, Michigan P.A. of 1970, the corner points mentioned in lines 1 and 2 above were in conformance with regulations and rules therefore as required in the current manual of survey instructions of the United States Department of the Interior, Bureau of Land Management or by a decree of a Court of Law and /or that the corner points mentioned in lines 3, 4 and 5 above were in conformance with the rules of the Michigan Board of Land Surveyors or by a Decree of a Court of Law; established, re-established, monumented, recovered, found as expressed below:

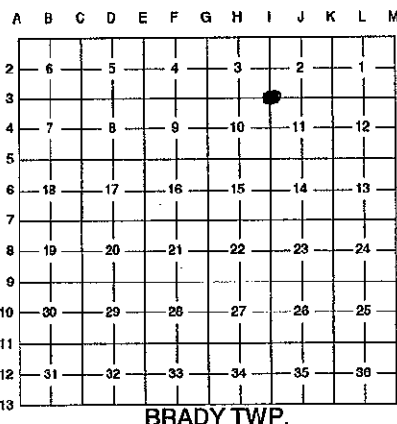

NOTE: Not more than 2 corners, all in the same town and range, may be recorded on this certificate.

A. Description of original monument and accessories and/or subsequent restoration:

G.L.O. IN DEC. 1826 BY R. CLARK, Jr.:
16" BEECH, N.18°E, 18 LINKS
36" MAPLE, S.32°W, 16 LINKS

RESURVEY IN JAN. 1876. F. HODGEMAN, C.S.:
8" ELM, S.49°E, 73 LINKS
4" MAPLE, N.68½°W, 95 LINKS

E. STRONG, C.S. MAY 1899
"FOUND GOOD"

SURVEY &
REMONUMENTATION

NOV 25 1998

SECTION

B. Description of corner evidence found and/or method applied in restoring or reestablishing corner:


FOUND 1" PIPE IN MONUMENT BOX. REMOVED AND FOUND 4"x5" STONE WITH DRILL HOLE UNDERNEATH. PIPE HAD BEEN PLACED BESIDE STONE. SET HARRISON MARKER AND MONUMENT BOX OVER STONE.

RATIFIED
BY KALAMAZOO COUNTY
REMONUMENTATION
PEER GROUP
3-19-1998

C. Description of monument for corner and accessories established to perpetuate locating the position of the corner:

FOUND STONE IS ACCEPTED AS THE BEST AVAILABLE EVIDENCE OF THE POSITION OF THE ORIGINAL CORNER. RAISED STONE WITH HARRISON MARKER AND MONUMENT BOX.

SET NAIL IN S.W. SIDE OF 24" ELM, S.36°E, 54.09'
SET NAIL IN S.W. SIDE OF 28" WALNUT, S.14°E, 91.94'
SET NAIL IN N.W. SIDE OF 14" CHERRY, S.40°W, 45.12'
FOUND NAIL & SPOTTER IN S.W. SIDE OF 36" WALNUT, N.40°W, 45.56'

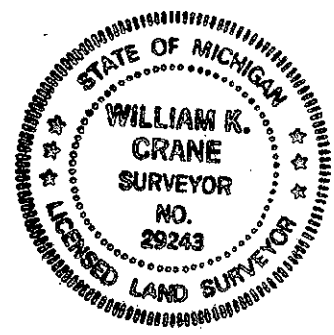

Signed by *William K. Crane*
William K. Crane, P.S.

Date 10/19/98

Surveyor's Michigan License No.: 29243