

SURVEY & REMONUMENTATION

APR 27 1995

COMMISSION

LAND CORNER RECORDATION CERTIFICATE Filing Requirement of Act 74, Mich. P.A. 1970

For corners in


Kalamazoo	Located In:	Corner Code #	
(County)			
Brady Township			
1. Public Land Survey	T <u>4</u> S R <u>10</u> W	J-5	
	T ___ R ___		
	T ___ R ___		
	T ___ R ___		
2. Property Controlling in Section	S ___ T ___ R ___		
	S ___ T ___ R ___		
3. Miscellaneous Property in Sec.	S ___ T ___ R ___		
	S ___ T ___ R ___		

STATE OF MICHIGAN
COUNTY OF KALAMAZOO
RECEIVED FOR RECORD
94 DEC 30 AM 9 18
LIBER 1 PG 1239
CLERK - REGISTER

Register of Deeds Stamp & File Number

4. Lot No. _____, Recorded Plat _____
5. Private Claims _____

I, Robert E. Snell, in a field survey on September 6, 1994, do hereby certify that under requirements of P.A. 74, Michigan P.A. of 1970, the corner points mentioned in lines 1 and 2 above were in conformance with regulations and rules therefore as required in the current manual of survey instructions of the United States Department of the Interior, Bureau of Land Management or by a decree of a Court of Law and/or that the corner points mentioned in lines 3, 4 and 5 above were in conformance with the rules of the Michigan Board of Land Surveyors or by a Decree of a Court of Law; established, re-established, monumented, re-monumented, recovered, found as expressed below:

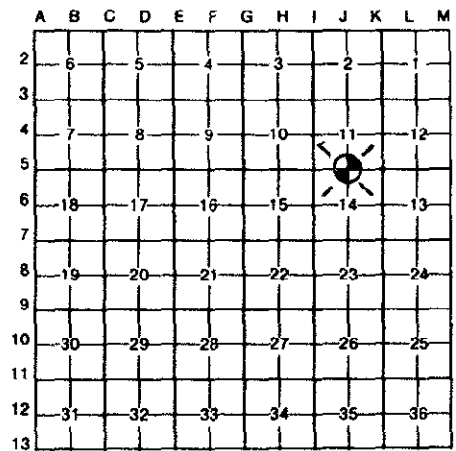

NOTE: Not more than 4 corners, all in the same town and range, may be recorded on this certificate.

- A. Description of original monument and accessories and/or subsequent restoration:
- 1826: U.S. Government Survey; Set 1/4 Section Post.
 - Bl. Ash 9" South 30° West 59 Lks
 - Bl. Ash 7" North 84½° East 58 Lks
 - 1899: Ed Strong, County Surveyor; Found stake and stone.
 - Elm 10" North 10°± West 31½ Lks

**RATIFIED
BY KALAMAZOO COUNTY
REMONUMENTATION
PEER GROUP
11-17-94**

R.E.S.

- B. Description of corner evidence found and/or method applied in restoring or reestablishing corner:
- 1975: J. Budzik, LCRC, Liber 1, Page 621; Found stone. Set iron/cap in monument box.
 - 1/2" Iron/Cap South 33'
 - Notch in East End Concrete Culvert South 05° East 19.83'
 - Notch in West End Concrete Culvert South 45° West 26.82'
 - Sq. Head Nail West Face 12" Elm North 35° West 40.69'
 - 1978: Al McMachen, LCRC, Liber 1, Page 830; Found iron in monument Box.
 - Fence Corner North 24.7' Fence Corner South 03° East 27.3'
 - 1994: Found 1/2" x 18" rerod with cap (#18982). Found 8" x 10" x 8" stone below iron and found remnants of stake below stone. There were no discernable markings on stone.

- C. Description of monument for corner and accessories established to perpetuate locating the position of the corner:
- J-5 South 1/4 Post Section 5, T. 4 S., R. 10 W., Ratified by the Kalamazoo County Remonumentation Program Peer Group on November 17, 1994. Found stone and stake as called for in 1899 survey by Ed Strong and is accepted as a careful and faithful perpetuation of the position of the original corner. Removed iron, lowered stone and placed a 20" Harrison monument inside monument box.
 - Traveled Center Line "V" Avenue South 0.75'
 - PK Nail in East Side 14" Sycamore South 22° West 79.60'
 - PK Nail in West Side 6" Maple South 10° West 60.32'
 - PK Nail in North Side 11" Elm South 70° East 105.25'
 - PK Nail in West Side 9" Walnut North 44° East 43.43'

Signed by *Robert E. Snell* Date 12/28/94
Surveyor's Michigan License No. 9734