

LAND CORNER RECORDATION CERTIFICATE
Filing Requirement of Act 74, Mich. P.A. 1970

LIBER 2 PAGE 341
STATE OF MICHIGAN
COUNTY OF KALAMAZOO
RECEIVED FOR RECORD

'98 OCT 20 AM 11 25

Smith Johnson

CLERK - REGISTER

Register of Deeds Stamp & File Number

KALAMAZOO
(County)


1. Public Land Survey Located In: Corner Code #
T 4S R 10W K-2
T _____ R _____
T _____ R _____
T _____ R _____

2. Property Controlling S _____ T _____ R _____
in Section S _____ T _____ R _____

3. Miscellaneous S _____ T _____ R _____
Property in Sec. S _____ T _____ R _____

4. Lot No. _____, Recorded Plat
5. Private Claims

I, WILLIAM K. CRANE, P.S., in a field survey on OCTOBER, 19 97 do hereby state that under requirements of P.A. 74, Michigan P.A. of 1970, the corner points mentioned in lines 1 and 2 above were in conformance with regulations and rules therefore as required in the current manual of survey instructions of the United States Department of the Interior, Bureau of Land Management or by a decree of a Court of Law and /or that the corner points mentioned in lines 3, 4 and 5 above were in conformance with the rules of the Michigan Board of Land Surveyors or by a Decree of a Court of Law; established, re-established, monumented, recovered, found as expressed below:

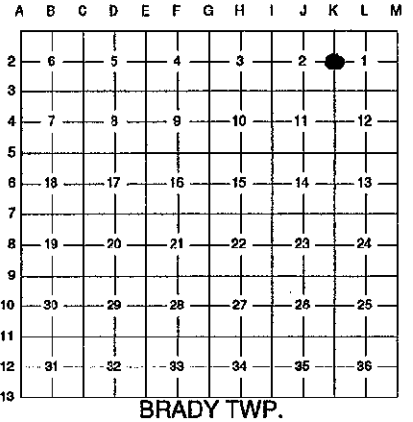

NOTE: Not more than 2 corners, all in the same town and range, may be recorded on this certificate.

A. Description of original monument and accessories and/or subsequent restoration:

G.L.O. IN DEC. 1826 BY R. CLARK, Jr.:
13" BEECH, S.11°W, 11 LINKS
6" BEECH, N.58°E, 4 LINKS

RESURVEY IN MAY 1877, F. HODGEMAN, C.S.:
12" BK WALNUT, N.83°40'W, 36 LINKS
6" MAPLE, N.60¼°E, 61 LINKS

SURVEY &
REMONUMENTATION

NOV 25 1998

SECTION

B. Description of corner evidence found and/or method applied in restoring or reestablishing corner:

FOUND "PK" NAIL OVER ¾" IRON IN MONUMENT BOX. REMOVED AND FOUND 5"x5"x10" OBLONG STONE WITH DRILL HOLE. IRON HAD BEEN PLACED BESIDE STONE. SET HARRISON MARKER AND MONUMENT BOX OVER STONE.

RATIFIED
BY KALAMAZOO COUNTY
REMONUMENTATION
PEER GROUP
3-19-1998


C. Description of monument for corner and accessories established to perpetuate locating the position of the corner:

FOUND STONE IS ACCEPTED AS THE BEST AVAILABLE EVIDENCE OF THE POSITION OF THE ORIGINAL CORNER. RAISED STONE WITH HARRISON MARKER AND MONUMENT BOX.

SET NAIL IN 8" MAPLE, N.80°W, 31.67'
SET NAIL IN U.P, N.80°E, 20.56'
SET NAIL IN 8" MAPLE, S.22°W, 52.66'
SET NAIL IN 24" WALNUT, S.48°W, 37.45'
1.5' EAST OF CENTERLINE OF NORTH-SOUTH ROAD
1.5' NORTH OF FENCE LINE WEST

Signed by William K. Crane
William K. Crane, P.S.

Date 10/19/98

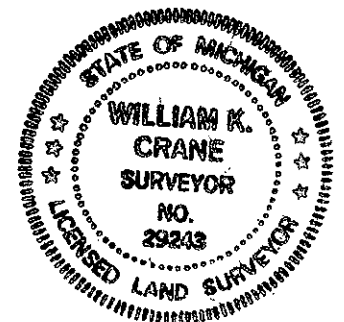

Surveyor's Michigan License No.: 29243

FORM APPROVED BY MICHIGAN STATE BOARD OF PROFESSIONAL SURVEYORS, JAN. 28, 1971

REVISED MAY 14, 1975
REVISED JAN., 1983
REVISED OCT., 1995