

SURVEY & REMONUMENTATION

APR 27 1995

COMMISSION

LAND CORNER RECORDATION CERTIFICATE
Filing Requirement of Act 74, Mich. P.A. 1970

STATE OF MICHIGAN
COUNTY OF KALAMAZOO
RECEIVED FOR RECORD

'94 DEC 15 PM 1 36

For corners in BRADY TWP.

KALAMAZOO
(County)

Located In:

Corner Code #

- | | | |
|------------------------------------|--------------------------|----------------|
| 1. Public Land Survey | T <u>4S</u> R <u>10W</u> | <u>B-1</u> |
| | T _____ R _____ | _____ |
| | T _____ R _____ | _____ |
| | T _____ R _____ | <u>Seq. #2</u> |
| 2. Property Controlling in Section | S _____ T _____ R _____ | _____ |
| | S _____ T _____ R _____ | _____ |
| 3. Miscellaneous Property in Sec. | S _____ T _____ R _____ | _____ |
| | S _____ T _____ R _____ | _____ |

James J. [Signature]
CLERK-REGISTER

LIBER 1 PG 1218

Register of Deeds Stamp & File Number

4. Lot No. _____, Recorded Plat _____
5. Private Claims _____

A	B	C	D	E	F	G	H	I	J	K	L	M
2	6	5	4	3	2	1						
3												
4	7	8	9	10	11	12						
5												
6	18	17	16	15	14	13						
7												
8	19	20	21	22	23	24						
9												
10	30	29	28	27	26	25						
11												
12	31	32	33	34	35	36						
13												

I, Allen H. McMachen a field survey on December 18, 19 93, do hereby certify that under requirements of P.A. 74, Michigan P.A. of 1970, the corner points mentioned in lines 1 and 2 above were in conformance with regulations and rules therefore as required in the current manual of survey instructions of the United States Department of the Interior, Bureau of Land Management or by a decree of a Court of Law and/or that the corner points mentioned in lines 3, 4 and 5 above were in conformance with the rules of the Michigan Board of Land Surveyors or by a Decree of a Court of Law; established, re-established, monumented, re-monumented, recovered, found as expressed below:

NOTE: Not more than 4 corners, all in the same town and range, may be recorded on this certificate.

A. Description of original monument and accessories and/or subsequent restoration:

1825 - Mullet set post - 18" OAK N. 74 deg. E. 86 LKS, 18" OAK N. 78 deg. W. 158 LKS

1895 - Strong found post "Found Without Trouble" no witnesses

1960 - Co. Surveyor found stone 52.6' East of Pavilion Cor.
36" OAK North 19.4'
24" OAK N. 75 deg. E. 16.8'
24" OAK N. 45 deg. W. 30.7'

B. Description of corner evidence found and/or method applied in restoring or reestablishing corner:


Found Pointed Stone 1.8' deep. 1989 - I.W.M. Survey (Job #18862) determined the found stone to be 0.9' South of the South line of SE $\frac{1}{4}$, Sec. 31, Pavilion Twp. The found stone is 52.5' East of a found Clay Tile at the South quarter corner of Sec. 31, Pavilion Twp., G.L.O. notes indicate jog of 80 links (52.8').

RATIFIED
BY KALAMAZOO COUNTY
REMONUMENTATION
PEER GROUP
12/30/93

C. Description of monument for corner and accessories established to perpetuate locating the position of the corner:

Found Pointed Stone is accepted as a careful and faithful perpetuation of the original corner. Placed Harrison Monument and Monument box over existing Pointed Stone, accessories:

- | | |
|--------------------------|------------------------------|
| Nail & Tab in S.W. face | 36" Oak N. 03 deg. E. 18.77' |
| Nail & Tab in South face | 24" Oak N. 70 deg. E. 17.29' |
| Nail & Tab in West face | 16" Oak S. 23 deg. E. 33.97' |
| Nail & Tab in East face | 12" Oak S. 60 deg. W. 30.42' |

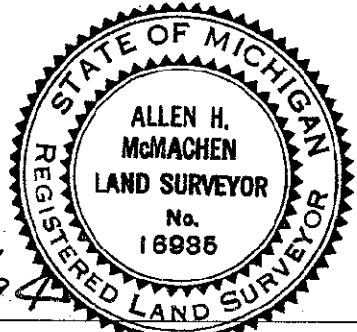

Signed by Allen H. McMachen
Surveyor's Michigan License No. 16935

Date 5/18/94