SURVEY & REMONUMENTATION

APR 27 1995

COMMISSION

STATE OF MICHIGAN
COUNTY OF KALAMAZOO
RECEIVED FOR RECORD
'94 DEC 14 PM 2 38

CLERK-REGISTER

LIBER 1 PG 1203

Register of Deeds Stamp & File Number

LAND CORNER RECORDATION CERTIFICATE

Filing Requirement of Act 74, Mich. P.A. 1970

For corners in Kalamazoo (County)

Schoolcraft Township

		Located In:	Corner Code ##
1. Public Land Survey		T 4 S R 11 W	A-5
		T ___ R ___	
		T ___ R ___	
		T ___ R ___	
2. Property Controlling	S ___	T ___ R ___	
in Section	S ___	T ___ R ___	
3. Miscellaneous	S ___	T ___ R ___	
Property in Sec.	S ___	T ___ R ___	

4. Lot No. _____, Recorded Plat _____
5. Private Claims _____

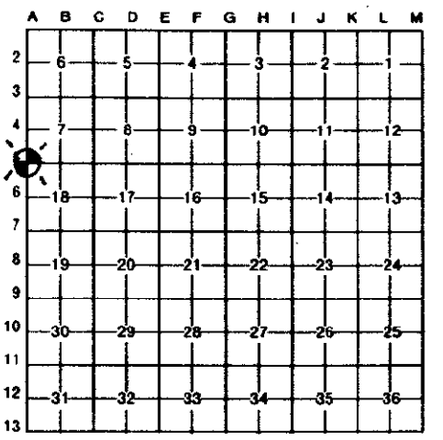

I, Robert E. Snell, in a field survey on May 17, 19 94, do hereby certify that under requirements of P.A. 74, Michigan P.A. of 1970, the corner points mentioned in lines 1 and 2 above were in conformance with regulations and rules therefore as required in the current manual of survey instructions of the United States Department of the Interior, Bureau of Land Management or by a decree of a Court of Law and/or that the corner points mentioned in lines 3, 4 and 5 above were in conformance with the rules of the Michigan Board of Land Surveyors or by a Decree of a Court of Law; established, re-established, monumented, re-monumented, recovered, found as expressed below:

NOTE: Not more than 4 corners, all in the same town and range, may be recorded on this certificate.

A. Description of original monument and accessories and/or subsequent restoration:

1826: U.S. Government Survey; Enter West Boundary at Post. Mound in prairie.

1889: F. Hodgman, County Surveyor; Found stone and bearing trees of resurvey all in place. Set Post (3" Tile)

NOTE: Schoolcraft A-5 is Common Corner Prairie Ronde M-5.

B. Description of corner evidence found and/or method applied in restoring or reestablishing corner:

1994: Found 3/8" rod below pavement and top section of 3" tile broken and laying on it's side below rod. Found second section of tile (2' in length) upright.

RATIFIED
BY KALAMAZOO COUNTY
REMONUMENTATION
PEER GROUP
7-21-94

C. Description of monument for corner and accessories established to perpetuate locating the position of the corner:

A-5 Southwest Corner Section 7, T. 4 S., R. 11 W., Ratified by the Kalamazoo County Remonumentation Program Peer Group on July 21, 1994. Found 3" round tile (2' section) as called for in 1889 remonumentation survey by F. Hodgman, and is accepted as a careful and faithful perpetuation of the original corner's position. Placed 16" of 20" Harrison monument with monument box over.

PK Nail in East Side	34" Maple	North 33° West	89.55'
PK Nail in East Side	30" Maple	North 20° West	141.54'
PK Nail in West Side	Power Pole	North 15° East	156.44'
PK Nail in West Side	Power Pole	South 12° East	102.18'
CL 12th Street		West	1.5'

Signed by Robert E. Snell Date 12-14-94

Surveyor's Michigan License No. 9734

FORM APPROVED BY MICHIGAN STATE BOARD OF LAND SURVEYORS, JAN. 28, 1971
REVISED MAY 14, 1975
REVISED JAN., 1983