

SURVEY & REMONUMENTATION

STATE OF MICHIGAN
COUNTY OF KALAMAZOO
RECEIVED FOR RECORD

AUG 22 1995

LAND CORNER RECORDATION CERTIFICATE

'95 MAR 23 PM 4 09

COMMISSION

Filing Requirement of Act 74, Mich. P.A. 1970

For corners in SCHOOLCRAFT TWP.

KALAMAZOO
(County)

Located In:

Corner Code #

- | | | |
|--------------------------------------|-------------------|-------|
| 1. Public Land Survey | T 4 S R 11 W | C-3 |
| | T ___ R ___ | _____ |
| | T ___ R ___ | _____ |
| | T ___ R ___ | _____ |
| 2. Property Controlling in Section | S ___ T ___ R ___ | _____ |
| | S ___ T ___ R ___ | _____ |
| 3. Miscellaneous Property in Section | S ___ T ___ R ___ | _____ |
| | S ___ T ___ R ___ | _____ |

James J. Jans

CLERK-REGISTER

LIBER 1 PG 1280

Register of Deeds Stamp & File Number

4. Lot No. _____, Recorded Plat _____
5. Private Claims _____

A	B	C	D	E	F	G	H	I	J	K	L	M
2	6	5	4	3	2	1						
3		●										
4	7	8	9	10	11	12						
5												
6	18	17	16	15	14	13						
7												
8	19	20	21	22	23	24						
9												
10	30	29	28	27	26	25						
11												
12	31	32	33	34	35	36						
13												

I, Allen H. McMachen field survey on January 9, 19 95, do hereby certify that under requirements of P.A. 74, Michigan P.A. of 1970, the corner points mentioned in lines 1 and 2 above were in conformance with regulations and rules therefore as required in the current manual of survey instructions of the United States Department of the Interior, Bureau of Land Management or by a decree of a Court of Law and/or that the corner points mentioned in lines 3, 4 and 5 above were in conformance with the rules of the Michigan Board of Professional Surveyors or by a Decree of a Court of Law; established, re-established, monumented, re-monumented, recovered, found as expressed below:

NOTE: Not more than 4 corners, all in the same town and range, may be recorded on this certificate.


A. Description of original monument and accessories and/or subsequent restoration:

- 1827 - R. Clark, D.S., Set Post
W. Oak 19" S. 49° E. 28 lks.
W. Oak 18" N. 37° W. 24 lks.
- 1889 - F. Hodgeman, C.S., Lost, set post midway between 1/4 post East and West and in center of road running East and West
Maple 12" S. 28° E. 63 2/3 lks.
Hick. 12" S. 52 1/2° W. 84 1/3 lks.

B. Description of corner evidence found and/or method applied in restoring or reestablishing corner:

Found Iron rod 6" below pavement surface, offset and removed iron and excavated through 12" of concrete and found Clay Tile 19" below surface. Clay Tile fit offsets.

RATIFIED
BY KALAMAZOO COUNTY
REMONUMENTATION
PEER GROUP
2/16/95

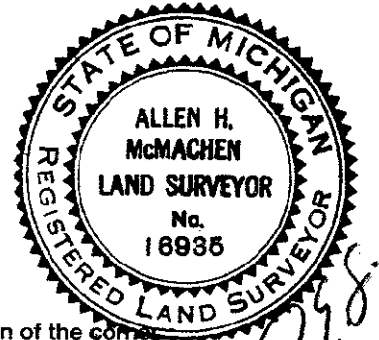

C. Description of monument for corner and accessories established to perpetuate locating the position of the corner:

Found Clay Tile is accepted as a careful and faithful reestablishment of the position of the original corner. Placed Harrison monument over existing Clay Tile and monument box over. Accessories:

- S.W. corner of block foundation of old School house N. 52 E. 83.97'
"PK" Nail & Tab in N. Face P. Pole S. 50° E. 39.87'
Nail & Tab in N. Face 6" Cherry S. 60° W. 54.08'
Nail & Tab in S. Face 14" Oak N. 60° W. 105.51'

Signed by Allen H. McMachen
Surveyor's Michigan License No. 16935

Date 3/22/95