

SURVEY &
REMONUMENTATION

LAND CORNER RECORDATION CERTIFICATE
Filing Requirement of Act 74, Mich. P.A. 1970

FEB 08 2000

For corners in Schoolcraft Twp.

SECTION

Kalamazoo Located in: Corner Code #
(County)

1. Public Land Survey T 4 S R 11 W C-05
T R
T R
T R

2. Property Controlling S T R
in Section S T R

3. Miscellaneous S T R
Property in Sec. S T R




Register of Deeds Stamp & File Number

4. Lot No. _____, Recorded Plat _____
5. Private Claims _____

I, Robert E. Snell, in a field survey on Sept. 17, 1999 do hereby state that under requirements of P.A. 74, Michigan P.A. of 1970, the corner points mentioned in lines 1 and 2 above were in conformance with regulations and rules therefore as required in the current manual of survey instructions of the United States Department of the Interior, Bureau of Land Management or by a decree of a Court of Law and/or that the corner points mentioned in lines 3, 4 and 5 above were in conformance with the rules of the Michigan Board of Land Surveyors or by a Decree of a Court of Law; established, re-established, monumented, recovered, found as expressed below:

NOTE: Not more than 2 corners, all in the same town and range, may be recorded on this certificate.

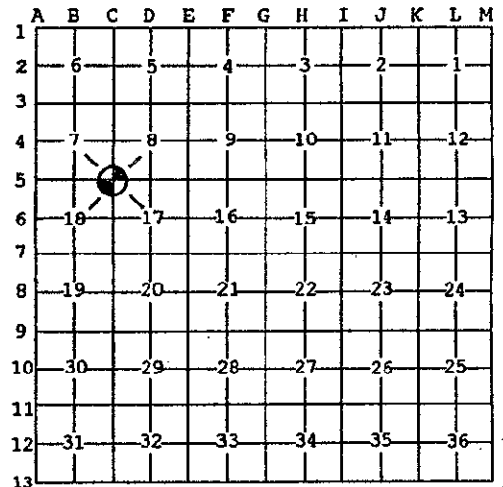

A. Description of original monument and accessories and/or subsequent restoration:

- 1826: United States Government Surveyors, Robert Clark; set post. Corner to Sections 7, 8, 17 & 18 in prairie and raised mound.
- 1870: F. Hodgman, County Surveyor; "Found old stake in the road. Planted stake with stone over it which Maple 2" S. 87° W. 36 1/2 lks., Maple 2" N. 39° W. 61 1/4 lks."
- 1889: F. Hodgman, County Surveyor; "Found stone of former survey with stake under and set post."

B. Description of corner evidence found and/or method applied in restoring or reestablishing corner:

1969: Wilkins & Wheaton Engr. Co.; found tile down 10" with large stone beside.

14" Black Walnut	N. 40° w.	35.0'
14" Black Walnut	N. 209° W.	58.0'
14" Black Walnut	N. 12° W.	87.0'
Iron Fence Post	N. 84°-30' W.	29.13'
Fence Corner	East	31.50'

RATIFIED
BY KALAMAZOO COUNTY
REMONUMENTATION
PEER GROUP
10-28-1999

1999: Found 3" round tile with "x" on top down 12". A large stone on North side of tile. Tile is 6.6' West and 1.7' South of iron at surface. Two stumps and one tree standing from 1969 survey.

C. Description of monument for corner and accessories established to perpetuate locating the position of the corner:

C-05: Southeast corner, Section 7, T. 4 S., R. 11 W., ratified by the Kalamazoo County Remonumentation Program Peer Group on October 28, 1999 and is accepted as a careful and faithful perpetuation of the position of the original corner. Found 3" round tile with "x" on top as set by F. Hodgman in 1889 Remonumentation survey. Placed remonumentation sleeve over tile with monument box over.

PK Nail in South Side	16" W. Cherry	N. 72° E.	35.65'
PK Nail in South Side	Power Pole	S. 52° E.	49.20'
Northeast Corner	Steel Fence Corner	N. 80° W.	29.35'
PK Nail in North Side	26" Walnut	N. 10° W.	87.09'

Signed by Robert E. Snell
Surveyor's Michigan License No. 9734

Date 11-15-99