

SURVEY & REMONUMENTATION

1
2
AUG 06 1996

COMMISSION LAND CORNER RECORDATION CERTIFICATE
Filing Requirement of Act 74, Mich. P.A. 1970


STATE OF MICHIGAN
COUNTY OF KALAMAZOO
RECEIVED FOR RECORD
196 MAY 23 PM 1 48
CLERK - REGISTER

For corners in Kalamazoo (County) Located In: Schoolcraft Twp. Corner Code #
1. Public Land Survey T 4 S. R 11 W. C-08
T _____ R _____
T _____ R _____
T _____ R _____
2. Property Controlling S _____ T _____ R _____
in Section S _____ T _____ R _____
3. Miscellaneous S _____ T _____ R _____
Property in Section S _____ T _____ R _____

LIBER 2PAGE 011
Register of Deeds Stamp & File Number

4. Lot No. _____, Recorded Plat _____
5. Private Claims _____
RATIFIED
BY KALAMAZOO COUNTY
REMONUMENTATION
PEER GROUP
4-18-1996

I, Robert E. Snell, in a field survey on March 13, 19 96, do hereby certify that under requirements of P.A. 74, Michigan P.A. of 1970, the corner points mentioned in lines 1 and 2 above were in conformance with regulations and rules therefore as required in the current manual of survey instructions of the United States Department of the Interior, Bureau of Land Management or by a decree of a Court of Law and/or that the corner points mentioned in lines 3, 4 and 5 above were in conformance with the rules of the Michigan Board of Professional Surveyors or by a Decree of a Court of Law; established, re-established, monumented, re-monumented, recovered, found as expressed below:

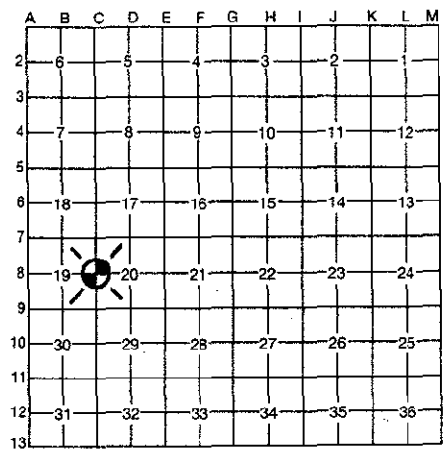

NOTE: Not more than 4 corners, all in the same town and range, may be recorded on this certificate.

A. Description of original monument and accessories and/or subsequent restoration:
1826: United States Government Surveyors; set 1/4 Section post in prairie & raised mound.
1889: F. Hodgman, County Surveyor; lost, set post in line and midway between Section corners North and South of it. Maple 3" N. 39 1/2° W. 50 1/2 lks., Blk. Walnut 2" N. 39 1/2° E. 90-1/3 lks. This post is about 40 lks. South of line of fences running East and West and about 12 lks. West of middle of road as fenced. I examined carefully in middle of road and in line with fences and found no sign of any stake or stone and could find no one who knew anything of the corner.

B. Description of corner evidence found and/or method applied in restoring or reestablishing corner:
1953: Wilkins & Wheaton Engr. Co.; found tile 0.9' below surface.
B. Walnut N. 39 1/2° E. 59.6' 24" B. Walnut S. 30°+ E. 65.70'
16" B. Walnut N. 50°+ W. 56.20' 16" Maple S. 85°+ W. 21.50'
1974: D. Gilchrist, R.L.S. #13583; L.C.R.C. L-1, P-517, 1/2" iron over tile.
26' + South of East & West Fence 6.5'+ West of Traveled centerline 14th St.
18" Walnut N. 45° E. 59.62' 20" Maple S. 85° W. 21.08'
30" Walnut S. 40° E. 65.33' 24" Maple S. 30° W. 38.0'
1996: Found tile in monument box. 3" round with "x" on top 12" below surface.

C. Description of monument for corner and accessories established to perpetuate locating the position of the corner:
C-08: East 1/4 post Section 19, T. 4 S., R. 11 W.; Ratified by the Kalamazoo County Remonumentation Program Peer Group on April 18, 1996 and is accepted as a careful and faithful perpetuation of the position of the original corner. Found 3" round tile with "x" on top in monument box. Tile set by F. Hodgman in a remonumentation survey in 1889. Set Remonumentation Sleeve over tile set in concrete in monument box.
PK Nail in Northwest Side 27" Walnut N. 40° E. 60.01'
PK Nail in North Side 42" Walnut S. 30° E. 64.68'
PK Nail in South Side 36" Maple S. 40° W. 37.25'
PK Nail in North Side 30" Maple West 21.23'

Signed by Robert E. Snell Date 5-23-96
Surveyor's Michigan License No. 9734
FORM APPROVED BY MICHIGAN STATE BOARD OF PROFESSIONAL SURVEYORS, JAN. 28, 1971
REVISED MAY 14, 1975
REVISED JAN., 1983