

MAY 1 8 1996

COMMISSION

STATE OF MICHIGAN
COUNTY OF KALAMAZOO
RECEIVED FOR RECORD
'96 APR 22 PM 4 23

LAND CORNER RECORDATION CERTIFICATE
Filing Requirement of Act 74, Mich. P.A. 1970

For corners in Kalamazoo (County) Located In: Schoolcraft Twp. Corner Code # C-09

1. Public Land Survey	T <u>4</u> S. R <u>11</u> W.	<u>C-09</u>
	T _____ R _____	_____
	T _____ R _____	_____
	T _____ R _____	_____
2. Property Controlling in Section	S _____ T _____ R _____	_____
	S _____ T _____ R _____	_____
3. Miscellaneous Property in Section	S _____ T _____ R _____	_____
	S _____ T _____ R _____	_____


4. Lot No. _____, Recorded Plat _____
5. Private Claims _____

James Young
CLERK-REGISTER

LIBER 1 PAGE 1481

Register of Deeds Stamp & File Number

I, Robert E. Snell, in a field survey on February 29, 1996, do hereby certify that under requirements of P.A. 74, Michigan P.A. of 1970, the corner points mentioned in lines 1 and 2 above were in conformance with regulations and rules therefore as required in the current manual of survey instructions of the United States Department of the Interior, Bureau of Land Management or by a decree of a Court of Law and/or that the corner points mentioned in lines 3, 4 and 5 above were in conformance with the rules of the Michigan Board of Professional Surveyors or by a Decree of a Court of Law; established, re-established, monumented, re-monumented, recovered, found as expressed below:

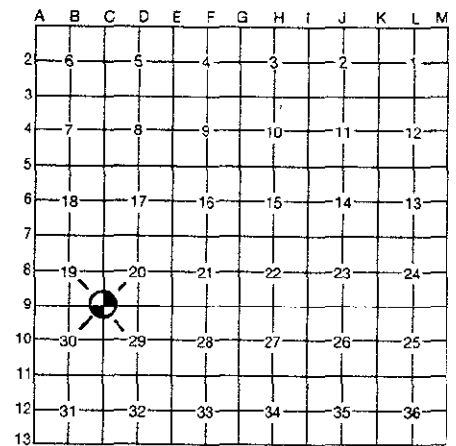

NOTE: Not more than 4 corners, all in the same town and range, may be recorded on this certificate.

A. Description of original monument and accessories and/or subsequent restoration:

- 1826: United States Government Surveyors; set post, corner to Sections 19, 20, 29 and 30 in prairie and raised mound.
- 1889: F. Hodgman, County Surveyor; found stone and brick corner of former survey in line with fences East and West. Set post.
Pear 3" S. 66° E. 71½ lks.

RATIFIED
BY KALAMAZOO COUNTY
REMONUMENTATION
PEER GROUP

B. Description of corner evidence found and/or method applied in restoring or reestablishing corner:

- 1953: Wilkins & Wheaton Engineering Co.; found tile 12" below surface in East and West fence line.
Northwest corner house Southeast 139.05'
12" B. Walnut N. 60° E. + 32.20'
14" B. Walnut N. 45° E. + 41.60'
- 1973: Acro Engineering Co.; 3/4" pipe NW cor. house S. 40° E. 139.05'
SE cor. house N. 80° W. 86.90'
18" Walnut N. 45° E. 41.20'
- 1974: Don Gilchrist, R.L.S. #13583; 3/4" iron over tile, 6" Walnut West 53.86'
16" Walnut N. 45° E. 40.76' 6" Maple S. 60° W. 22.87'

3/21/96
[Signature]

C. Description of monument for corner and accessories established to perpetuate locating the position of the corner:

C-09: Southwest corner, Section 20, T. 4 S., R. 11 W., Ratified by the Kalamazoo County Remonumentation Program Peer Group on March 21, 1996, and is accepted as a careful and faithful perpetuation of the position of the original corner. Found 3/4" x 8" iron over 3" round tile with "x" on top in a monument box. The tile was set by F. Hodgman, County Surveyor in a Remonumentation survey in 1889. Removed iron and placed remonumentation sleeve over tile with concrete around in monument box.

- PK Nail in Northwest Side 22" Walnut N. 54° E. 41.20'
- Exist. Nail/Tab in South Side Power Pole N. 80° E. 64.15'
- PK Nail in Northeast Side Telephone Pole S. 50° E. 78.47'
- Exist. Nail/Tab in South Side Power Pole West 28.15'

Signed by *Robert E. Snell* Date 4-19-96

Surveyor's Michigan License No. 9734