

1
2
AUG 22 1995

COMMISSION LAND CORNER RECORDATION CERTIFICATE

Filing Requirement of Act 74, Mich. P.A. 1970 FEB 9 PM 3 58

For corners in SCHOOLCRAFT TWP.

KALAMAZOO (County)

Located In:

Corner Code #

James J. [Signature]

CLERK-REGISTER

LIBER 1 PG 1270

Register of Deeds Stamp & File Number

1. Public Land Survey	T 4 S R 11 W	D-5
	T _____ R _____	_____
	T _____ R _____	_____
	T _____ R _____	_____
2. Property Controlling in Section	S _____ T _____ R _____	_____
	S _____ T _____ R _____	_____
3. Miscellaneous Property in Section	S _____ T _____ R _____	_____
	S _____ T _____ R _____	_____

4. Lot No. _____, Recorded Plat _____

5. Private Claims _____

A	B	C	D	E	F	G	H	I	J	K	L	M
2	6	5	4	3	2	1						
3												
4	7	8	9	10	11	12						
5												
6	18	17	16	15	14	13						
7												
8	19	20	21	22	23	24						
9												
10	30	29	28	27	26	25						
11												
12	31	32	33	34	35	36						
13												

I, Allen H. McMachen field survey on December 29, 19 94, do hereby certify that under requirements of P.A. 74, Michigan P.A. of 1970, the corner points mentioned in lines 1 and 2 above were in conformance with regulations and rules therefore as required in the current manual of survey instructions of the United States Department of the Interior, Bureau of Land Management or by a decree of a Court of Law and/or that the corner points mentioned in lines 3, 4 and 5 above were in conformance with the rules of the Michigan Board of Professional Surveyors or by a Decree of a Court of Law; established, re-established, monumented, re-monumented, recovered, found as expressed below:

NOTE: Not more than 4 corners, all in the same town and range, may be recorded on this certificate.

A. Description of original monument and accessories and/or subsequent restoration:

- 1826 - U.S. Government Survey; Set 1/4 Post
W. Oak N. 15° E. 82 lks.
W. Oak N. 78° W. 73 lks.
- 1889 - F. Hodgeman, C.S., Found stone set at intersection of fences
S. 15° W. 82 lks. from stump of U.S. bearing tree. Set Post
Cherry 10" S. 89° W. 166 lks.
- 1966 - Wilkins & Wheaton Engineering Co., Tile at N 1/4 Post (Sec. 17) is at fence intersection (old fence) at surface, no digging necessary.

B. Description of corner evidence found and/or method applied in restoring or reestablishing corner:

Found Clay Tile at surface (0.8' West of fence).


RATIFIED
BY KALAMAZOO COUNTY
REMONUMENTATION
PEER GROUP

1/19/95
R.E.F.

C. Description of monument for corner and accessories established to perpetuate locating the position of the corner:

Found Clay Tile is accepted as a careful and faithful perpetuation of the position of the original corner. Placed standard sleeve over existing Tile. Accessories:

- Iron rod with cap N. 45° W. 5.00'
- Iron rod with cap S. 45° W. 5.00'
- Nail & Tab in N. side 8" Oak SOUTH 3.71'
- Nail & Tab in S. side 5" Triple Maple WEST 37.63'

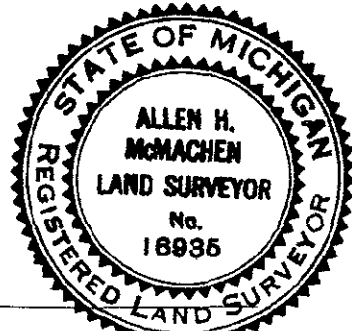

Signed by Allen H. McMachen
Surveyor's Michigan License No. 16935

Date 2/9/95