

SURVEY & REMONUMENTATION

1
2
AUG 06 1996

COMMISSION

LAND CORNER RECORDATION CERTIFICATE
Filing Requirement of Act 74, Mich. P.A. 1970

For corners in
Kalamazoo
(County)
Schoolcraft Twp.

Located In:


Corner Code #

- | | | | | | |
|--------------------------------------|---|------|---|-------|------|
| 1. Public Land Survey | T | 4 S. | R | 11 W. | E-06 |
| | T | | R | | |
| | T | | R | | |
| | T | | R | | |
| 2. Property Controlling in Section | S | | T | R | |
| | S | | T | R | |
| 3. Miscellaneous Property in Section | S | | T | R | |
| | S | | T | R | |

LIBER 2 PAGE 014
96 MAY 23 PM 1 48
STATE OF MICHIGAN
COUNTY OF KALAMAZOO
RECEIVED FOR RECORD
Register of Deeds Stamp & File Number

4. Lot No. _____, Recorded Plat _____
5. Private Claims _____

I, Robert E. Snell, in a field survey on March 13, 1996, do hereby certify that under requirements of P.A. 74, Michigan P.A. of 1970, the corner points mentioned in lines 1 and 2 above were in conformance with regulations and rules therefore as required in the current manual of survey instructions of the United States Department of the Interior, Bureau of Land Management or by a decree of a Court of Law and/or that the corner points mentioned in lines 3, 4 and 5 above were in conformance with the rules of the Michigan Board of Professional Surveyors or by a Decree of a Court of Law; established, re-established, monumented, re-monumented, recovered, found as expressed below:

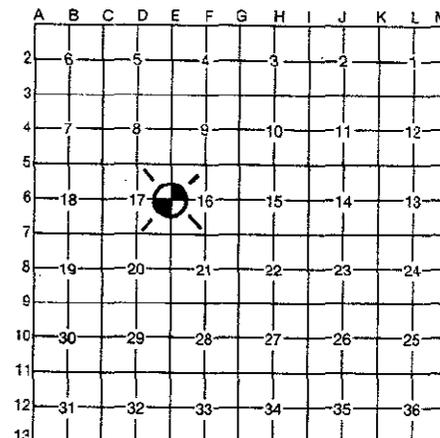

NOTE: Not more than 4 corners, all in the same town and range, may be recorded on this certificate.

A. Description of original monument and accessories and/or subsequent restoration:

1826: United States Government Surveyors; set 1/4 post common to Sections 16 & 17.
Br. Oak 11" N. 28¹/₂^o E. 356 lks.
Br. Oak 11" S. 75^o E. 146 lks.

1889: F. Hodgman, County Surveyor; found old stake at intersection of roads in middle of roads and in line with fence north.
Blk. Walnut 12" S. 39^o E. 71¹/₂ lks.
Elm 3" S. 40^o W. 70¹/₂ lks.

B. Description of corner evidence found and/or method applied in restoring or reestablishing corner:

1958: Wilkins & Wheaton Engr. Co.; found tile 12" deep at intersection of roads.
Fence on line to North
24" Elm S. 40^o W. 45.76'
24" Elm N. 40^o E. 37.60'
20" Maple S. 45^o E. 59.70'

1996: Found iron bar over tile with cross in top 12" Deep in monument box.

RATIFIED
BY KALAMAZOO COUNTY
REMONUMENTATION
PEER GROUP
4-18-1996

C. Description of monument for corner and accessories established to perpetuate locating the position of the corner:

E-6: 1/4 post common to Sections 16 & 17, T. 4 S., R. 11 W., Ratified by the Kalamazoo County Remonumentation Program Peer Group on April 18, 1996 and is accepted as a careful and faithful perpetuation of the position of the original corner. Found 3" round tile with cross in top as set by F. Hodgman, County Surveyor in a remonumentation survey in 1889. Set remonumentation sleeve in concrete in monument box over tile.

PK Nail on East Side of 20" Cherry	N. 08 ^o E.	39.41'
NE corner of R.R. rail fence post (taken at ground level)	S. 54 ^o W.	49.55'
PK Nail on South Side of Power Pole	N. 54 ^o W.	49.68'
PK Nail on Northeast Side of Oak	N. 20 ^o W.	34.60'

Signed by Robert E. Snell
Surveyor's Michigan License No. 9734

Date 5-23-96