

SURVEY & REMONUMENTATION

STATE OF MICHIGAN
COUNTY OF KALAMAZOO
RECEIVED FOR RECORD

APR 27 1995

LAND CORNER RECORDATION CERTIFICATE

DEC 14 PM 2 39

COMMISSION

Filing Requirement of Act 74, Mich. P.A. 1970

For corners in

Kalamazoo
(County)

Located In:

Corner Code #

Schoolcraft Township

T 4 S R 11 W

E-10

T _____ R _____

T _____ R _____

T _____ R _____

S _____ T _____ R _____

S _____ T _____ R _____

S _____ T _____ R _____

S _____ T _____ R _____

1. Public Land Survey

2. Property Controlling in Section

3. Miscellaneous Property in Sec.

4. Lot No. _____, Recorded Plat _____

5. Private Claims _____

James J. [Signature]

CLERK-REGISTER

LIBER

1 PG 1206

Register of Deeds Stamp & File Number

I, Robert E. Snell, in a field survey on June 28, 19 94

do hereby certify that under requirements of P.A. 74, Michigan P.A. of 1970, the corner points mentioned in lines 1 and 2 above were in conformance with regulations and rules therefore as required in the current manual of survey instructions of the United States Department of the Interior, Bureau of Land Management or by a decree of a Court of Law and/or that the corner points mentioned in lines 3, 4 and 5 above were in conformance with the rules of the Michigan Board of Land Surveyors or by a Decree of a Court of Law; established, re-established, monumented, re-monumented, recovered, found as expressed below:

NOTE: Not more than 4 corners, all in the same town and range, may be recorded on this certificate.


A. Description of original monument and accessories and/or subsequent restoration:

1826: U.S. Government Survey; Set 1/4 Post, in prairie and raised mound.

1889: F. Hodgman, County Surveyor; Found stone and brick of former survey at center (of) intersection of roads. Set Post.

B. Description of corner evidence found and/or method applied in restoring or reestablishing corner:

1994: Found tile with stone and brick around, 26" below surface.

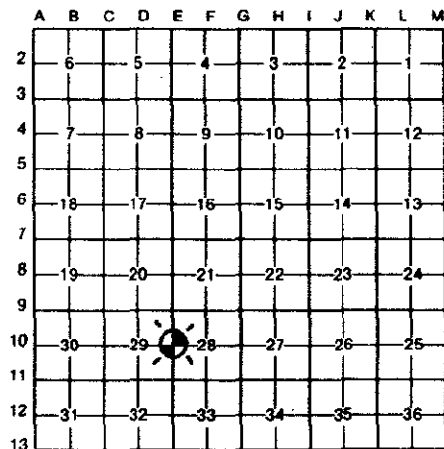

RATIFIED
BY KALAMAZOO COUNTY
REMONUMENTATION
PEER GROUP
9-15-94
2.28

C. Description of monument for corner and accessories established to perpetuate locating the position of the corner:

E-10 West 1/4 Post Section 28, T. 4 S., R. 11 W., Ratified by the Kalamazoo County Remonumentation Program Peer Group on September 15, 1994. Found 3" round tile as called for in 1889 remonumentation survey by F. Hodgman and is accepted as a careful and faithful perpetuation of the original corner's position. Placed 20" Harrison monument and monument box over tile.

PK Nail in East Side	Power Pole	North 32° East	50.13'
PK Nail in West Side	Power Pole	North 32° West	89.05'
PK Nail in East Side	10" Ash	North 14° West	105.68'
PK Nail in Bend on South Side	8" Crabapple	North 66° West	102.17'
CL "XY" Avenue		North	2.0'
CL 16th Street		In Line	

Signed by *Robert E. Snell*
Surveyor's Michigan License No. 9734

Date 12-14-94