

FEB 18 1994

LIBER 1 PG 1002

COMMISSION

LAND CORNER RECORDATION CERTIFICATE  
Filing Requirement of Act 74, Mich. P.A. 1970

STATE OF MICHIGAN  
COUNTY OF KALAMAZOO  
RECEIVED FOR RECORD  
93 OCT 25 AM 9 38  
Clerk-Register


For corners in

<u>Kalamazoo</u> (County)	Located In:	Corner Code #
Schoolcraft Township		
1. Public Land Survey	T <u>4S</u> R <u>11W</u>	<u>F-7</u>
	T _____ R _____	_____
	T _____ R _____	_____
	T _____ R _____	_____
2. Property Controlling in Section	S _____ T _____ R _____	_____
	S _____ T _____ R _____	_____
3. Miscellaneous Property in Sec.	S _____ T _____ R _____	_____
	S _____ T _____ R _____	_____

Register of Deeds Stamp & File Number

- 4. Lot No. \_\_\_\_\_, Recorded Plat \_\_\_\_\_
- 5. Private Claims \_\_\_\_\_

I, John G. Kester, in a field survey on July 30, 19 93, do hereby certify that under requirements of P.A. 74, Michigan P.A. of 1970, the corner points mentioned in lines 1 and 2 above were in conformance with regulations and rules therefore as required in the current manual of survey instructions of the United States Department of the Interior, Bureau of Land Management or by a decree of a Court of Law and/or that the corner points mentioned in lines 3, 4 and 5 above were in conformance with the rules of the Michigan Board of Land Surveyors or by a Decree of a Court of Law; established, re-established, monumented, re-monumented, recovered, found as expressed below:

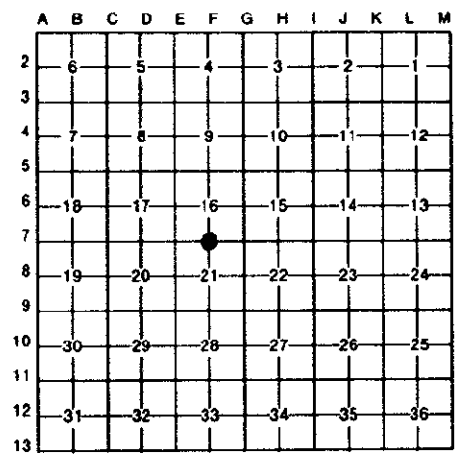

NOTE: Not more than 4 corners, all in the same town and range, may be recorded on this certificate.

A. Description of original monument and accessories and/or subsequent restoration:

Corner Post established by U.S. Government Deputy Surveyor Robert Clark, 1826, no accessories. Resurvey by F. Hodgeman, 1889, Found Stone set for corner in middle of road and in line with fence South. Set Post (Solid Clay Tile with "X" on top), Accessory: Maple 16" S30W 12 Lks.

B. Description of corner evidence found and/or method applied in restoring or reestablishing corner:

Original Corner not recovered.  
Found Monument Box over 5/8" iron above Solid Clay Tile with "X" on top as called for in 1889 resurvey by F. Hodgeman. All accessories gone.

RATIFIED  
BY KALAMAZOO COUNTY  
REMONUMENTATION  
PEER GROUP  
8-19-93

C. Description of monument for corner and accessories established to perpetuate locating the position of the corner:

F-7, S 1/4 Corner Section 16, T4S - R 11 W, Ratified by Kalamazoo County Remonumentation Program Peer Group on August 19, 1993. Found Solid Clay Tile with "X" on top called for in 1889 resurvey and is accepted as a careful and faithful perpetuation of the position of the original Corner. Removed existing Monument Box and 5/8" iron. Placed 20" Harrison Monument above Tile and placed Monument Box over Corner.

- Set P.K. Nail in fence post N 50 W 77.65'
- Set P.K. Nail in 6" Ash cluster North 33.98'
- Set 1/2" Rebar S 45 W 29.09'
- Set 1/2" Rebar S 45 E 27.24'

Signed by John G. Kester Date 10-20-93

Surveyor's Michigan License No. 16046

Kalamazoo County Road Commission

