

MAY 14 1996

COMMISSION

LAND CORNER RECORDATION CERTIFICATE '96
Filing Requirement of Act 74, Mich. P.A. 1970

STATE OF MICHIGAN
COUNTY OF KALAMAZOO
RECEIVED FOR RECORD

96 MAR 13 PM 3 42

For corners in

Kalamazoo
(County)

Located In:

Corner Code #

Schoolcraft Twp.

1. Public Land Survey	T	4	S.	R	11	W.	F-11
	T			R			
	T			R			
	T			R			
2. Property Controlling in Section	S		T		R		
	S		T		R		
3. Miscellaneous Property in Section	S		T		R		
	S		T		R		


James J. Young
CLERK-REGISTER

LIBER 1 1445

Register of Deeds Stamp & File Number

- 4. Lot No. _____, Recorded Plat _____
- 5. Private Claims _____

I, Robert E. Snell, in a field survey on January 23, 1996, do hereby certify that under requirements of P.A. 74, Michigan P.A. of 1970, the corner points mentioned in lines 1 and 2 above were in conformance with regulations and rules therefore as required in the current manual of survey instructions of the United States Department of the Interior, Bureau of Land Management or by a decree of a Court of Law and/or that the corner points mentioned in lines 3, 4 and 5 above were in conformance with the rules of the Michigan Board of Professional Surveyors or by a Decree of a Court of Law; established, re-established, monumented, re-monumented, recovered, found as expressed below:

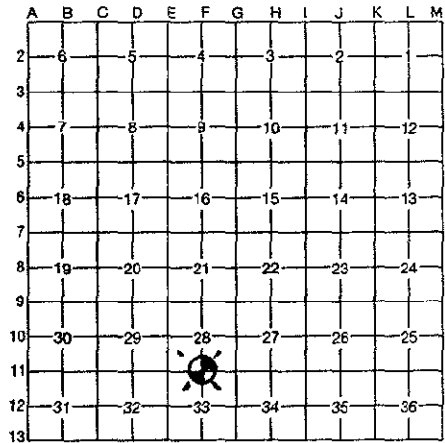

NOTE: Not more than 4 corners, all in the same town and range, may be recorded on this certificate.

A. Description of original monument and accessories and/or subsequent restoration:

1826: United States Government Surveyors; set 1/4 Section post.
 Br. Oak 12" S. 13° W. 65 lks.
 Br. Oak 9" N. 81° E. 51 lks.

1879: F. Hodgman, County Surveyor; stone set on former survey.

1889: F. Hodgman, County Surveyor; found stone, set post, nothing near for witness.

B. Description of corner evidence found and/or method applied in restoring or reestablishing corner:

1996: Found tile South of large stone, both just below surface. Witness notes of Acro Engineering, date unknown.

"x" in tile Southwest of 18" stone
 6" Walnut N. 55° E. 7.92' (to Nail) gone.
 10" DbL. Cherry S. 15° W. 16.6'
 Center line corner fence post N. 40° W. 2.02'

RATIFIED
 BY KALAMAZOO COUNTY
 REMONUMENTATION
 PEER GROUP
 2-15-96

C. Description of monument for corner and accessories established to perpetuate locating the position of the corner:

F-11: South 1/4 post Section 28, T. 4 S., R. 11 W., Ratified by the Kalamazoo County Remonumentation Program Peer Group on February 15, 1996 and is accepted as a careful and faithful perpetuation of the position of the original corner. Found 3" round tile with "x" as set by F. Hodgman in 1889 Remonumentation survey. Placed a remonumentation sleeve over tile.

North & South fence	Wood fence post	West	1.75'
PK Nail in West side	28" Oak	S. 10° E.	32.94'
PK Nail in West side	DbL. 14" W. Cherry	S. 14° E.	16.42' (South Branch)
PK Nail in East side	8" W. Cherry	N. 08° E.	5.60'
PK Nail in East side	15" W. Cherry	North	16.75'

Signed by Robert E. Snell

Date 3-12-96

Surveyor's Michigan License No. 9734