

**SURVEY & REMONUMENTATION**

MAY 16 1996

COMMISSION

STATE OF MICHIGAN  
COUNTY OF KALAMAZOO  
RECEIVED FOR RECORD

**LAND CORNER RECORDATION CERTIFICATE**  
Filing Requirement of Act 74, Mich. P.A. 1970

APR 22 PM 4 23

For corners in Kalamazoo (County) Located In: \_\_\_\_\_ Corner Code # \_\_\_\_\_  
Schoolcraft Twp.

1. Public Land Survey	T 4 S. R 11 W.	G-01
	T _____ R _____	_____
	T _____ R _____	_____
	T _____ R _____	_____
2. Property Controlling in Section	S _____ T _____ R _____	_____
	S _____ T _____ R _____	_____
3. Miscellaneous Property in Section	S _____ T _____ R _____	_____
	S _____ T _____ R _____	_____

4. Lot No. \_\_\_\_\_, Recorded Plat \_\_\_\_\_  
5. Private Claims \_\_\_\_\_


*Jamie Young*  
CLERK-REGISTER

LIBER 1 PAGE 1482

Register of Deeds Stamp & File Number

I, Robert E. Snell, in a field survey on February 29, 19 96 do hereby certify that under requirements of P.A. 74, Michigan P.A. of 1970, the corner points mentioned in lines 1 and 2 above were in conformance with regulations and rules therefore as required in the current manual of survey instructions of the United States Department of the Interior, Bureau of Land Management or by a decree of a Court of Law and/or that the corner points mentioned in lines 3, 4 and 5 above were in conformance with the rules of the Michigan Board of Professional Surveyors or by a Decree of a Court of Law; established, re-established, monumented, re-monumented, recovered, found as expressed below:

**NOTE: Not more than 4 corners, all in the same town and range, may be recorded on this certificate.**

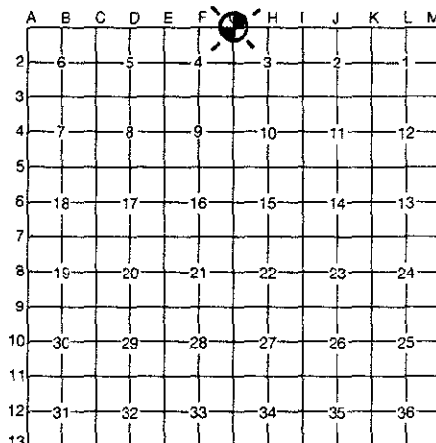

**A. Description of original monument and accessories and/or subsequent restoration:**

1826: United States Government Surveyors; entered North boundary 77 lks. East of post. Set post at intersection corner to Sections 3 and 4.

W. Oak 13" N. 05° E. 215 lks.  
Y. Oak 18" N. 57° W. 238 lks.

1889: F. Hodgman, County Surveyor; set post S. 05° W., 215 lks. from W. Oak 16" bearing tree, W. Oak 8" N. 40° W., 69 lks. This is 55½ lks. East of a stone set for Portage corner and S. 57° E. 238 lks. from remains of the other U.S. bearing tree.

**B. Description of corner evidence found and/or method applied in restoring or reestablishing corner:**

1976: Wenley Smith, R.L.S. #6523; L.C.R.C. L-1, P-690, tile WR&C.

Power Pole S. 40° E. 42.0'  
Northeast corner Bldg. S. 85° W. 47.7'  
26" Ash N. 20° W. 92.0'

1996: Found 3" round tile with "x" on top. Did not find ring and cover, Portage corner (G-13) stone, West, 36.70'.

**RATIFIED BY KALAMAZOO COUNTY REMONUMENTATION PEER GROUP**  
3/21/96

**C. Description of monument for corner and accessories established to perpetuate locating the position of the corner:**

G-01: Northeast corner Section 3, T. 4 S., R. 11 W., Ratified by the Kalamazoo County Remonumentation Program Peer Group on March 21, 1996, and is accepted as a careful and faithful perpetuation of the position of the original corner. Found 3" round tile with "x" on top as set by F. Hodgman in a Remonumentation survey in 1889. Placed remonumentation sleeve over tile.

PK Nail in South Side Triple 8" Maple N. 70° W. 13.92'  
PK Nail in South Side Triple 9" Maple N. 84° E. 16.62'  
PK Nail in West Side 5" Oak S. 16° E. 19.60'  
PK Nail in North Side 14" Elm S. 52° W. 12.62'

Signed by Robert E. Snell

Date 4-22-96

Surveyor's Michigan License No. 9734