

MAY 16 1996

COMMISSION

LAND CORNER RECORDATION CERTIFICATE

Filing Requirement of Act 74, Mich. P.A. 1970

STATE OF MICHIGAN
COUNTY OF KALAMAZOO
RECEIVED FOR RECORD

'96 MAR 13 PM 3 42

For corners in
Kalamazoo
(County)

Located In:

Corner Code #

Schoolcraft Twp.

1. Public Land Survey	T <u>4</u> S. R <u>11</u> W.	<u>G-11</u>
	T _____ R _____	_____
	T _____ R _____	_____
	T _____ R _____	_____
2. Property Controlling in Section	S _____ T _____ R _____	_____
	S _____ T _____ R _____	_____
3. Miscellaneous Property in Section	S _____ T _____ R _____	_____
	S _____ T _____ R _____	_____


James J. Young
CLERK-REGISTER

LIBER 1 1449

Register of Deeds Stamp & File Number

4. Lot No. _____, Recorded Plat _____
5. Private Claims _____

I, Robert E. Snell, in a field survey on January 23, 1996, do hereby certify that under requirements of P.A. 74, Michigan P.A. of 1970, the corner points mentioned in lines 1 and 2 above were in conformance with regulations and rules therefore as required in the current manual of survey instructions of the United States Department of the Interior, Bureau of Land Management or by a decree of a Court of Law and/or that the corner points mentioned in lines 3, 4 and 5 above were in conformance with the rules of the Michigan Board of Professional Surveyors or by a Decree of a Court of Law; established, re-established, monumented, re-monumented, recovered, found as expressed below:

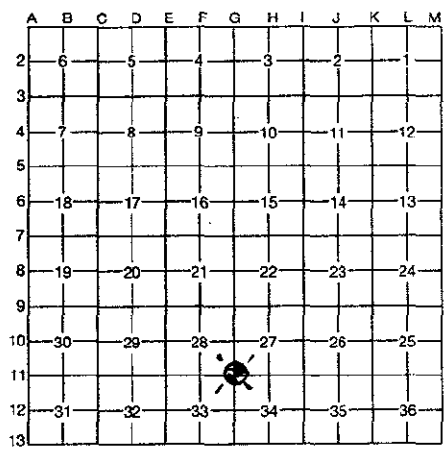

NOTE: Not more than 4 corners, all in the same town and range, may be recorded on this certificate.

A. Description of original monument and accessories and/or subsequent restoration:

- 1826: United States Government Surveyors; set post to corner of Sections 27, 28, 33 & 34.
W. Oak 16" N. 87° W. 159 lks.
W. Oak 18" N. 69° E. 132 lks.
- 1879: F. Hodgman, County Surveyor; found stake from U.S. bearing trees alive and standing. The West one (...?)
- 1889: F. Hodgman, County Surveyor; set post.
Y. Oak 6" S. 20° W. 6 lks.

B. Description of corner evidence found and/or method applied in restoring or reestablishing corner:

- 1996: Found tile at surface with large stone just South of tile and below surface from Acro Engineering witness notes, date unknown.
"x" in tile next to large stone.
18" Oak N. 40° E. 12.0' (to PK)
16" Hickory East 33.7' (to PK)
8" Oak S. 10° E. 19.3 (to PK)

RATIFIED
BY KALAMAZOO COUNTY
REMONUMENTATION
PEER GROUP
2-15-96
[Signature]

C. Description of monument for corner and accessories established to perpetuate locating the position of the corner:

- G-11: Southeast corner Section 28, T. 4 S., R. 11 W., Ratified by Kalamazoo County Remonumentation Program Peer Group on February 15, 1996 and is accepted as a careful and faithful perpetuation of the position of the original corner. Found 3" round tile with "x" on top as placed by F. Hodgman in 1889 Remonumentation survey. Placed a remonumentation sleeve over tile.
- | | | | |
|------------------------|----------------------------|-----------|--------------------------------|
| Southwest corner | Railroad rail fence corner | North | 5.21' Fence North & West |
| PK Nail in East side | 24" Oak | N. 40° E. | 12.11' |
| PK Nail in West side | 18" Oak | S. 20° E. | 19.66' ← (Note: There is a PK) |
| PK Nail in West Branch | 18" Triple Hickory | N. 78° E. | 32.26' (Nail in face also.) |
| PK Nail in South side | 6" W. Cherry | N. 40° W. | 32.27' |

Signed by Robert E. Snell

Date 3-12-96

Surveyor's Michigan License No. 9734