

AUG 22 1995

COMMISSION

LAND CORNER RECORDATION CERTIFICATE

Filing Requirement of Act 74, Mich. P.A. 1970

For corners in SCHOOLCRAFT TWP.

KALAMAZOO (County)

Located In:

Corner Code #

1. Public Land Survey	T 4 S R 11 W	H-3
	T ___ R ___	___
	T ___ R ___	___
	T ___ R ___	___
2. Property Controlling in Section	S ___ T ___ R ___	___
	S ___ T ___ R ___	___
3. Miscellaneous Property in Section	S ___ T ___ R ___	___
	S ___ T ___ R ___	___

STATE OF MICHIGAN COUNTY OF KALAMAZOO RECEIVED FOR RECORD

'95 MAR 23 PM 4 09


James [Signature] CLERK-REGISTER

LIBER 1 PG 1278

Register of Deeds Stamp & File Number

4. Lot No. _____, Recorded Plat _____
5. Private Claims _____

I, Allen H. McMachen a field survey on January 9, 19 95, do hereby certify that under requirements of P.A. 74, Michigan P.A. of 1970, the corner points mentioned in lines 1 and 2 above were in conformance with regulations and rules therefore as required in the current manual of survey instructions of the United States Department of the Interior, Bureau of Land Management or by a decree of a Court of Law and/or that the corner points mentioned in lines 3, 4 and 5 above were in conformance with the rules of the Michigan Board of Professional Surveyors or by a Decree of a Court of Law; established, re-established, monumented, re-monumented, recovered, found as expressed below:

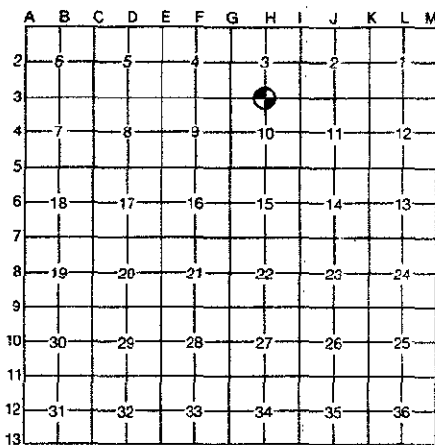

NOTE: Not more than 4 corners, all in the same town and range, may be recorded on this certificate.

A. Description of original monument and accessories and/or subsequent restoration:

1826 - R. Clark, D.S., Set Quarter Section Post
W. Oak 20" S. 76° E. 29 lks.
W. Oak 18" N. 7° W. 57 1/2 lks.


1889 - F. Hodgeman, C.S., Found old Stake N. 76° W. 29 lks. from roots of bearing tree, Set Post, Hickory 12" N. 38° E. 58 3/4 lks.
Oak 12" Top broke off, SOUTH 32 lks.

B. Description of corner evidence found and/or method applied in restoring or reestablishing corner:

Found Iron rod in monument box 6" below surface of pavement per previous survey witnesses. Offset and removed box and Iron. Dug and found Clay Tile 18" below surface. Clay Tile fit offsets.

RATIFIED BY KALAMAZOO COUNTY REMONUMENTATION PEER GROUP

2/16/95

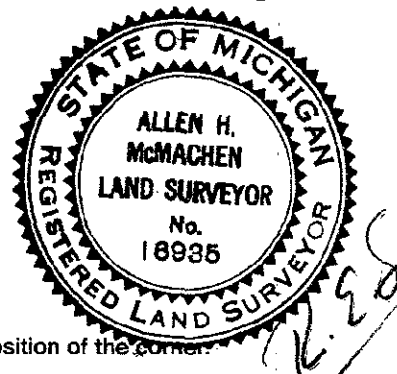

C. Description of monument for corner and accessories established to perpetuate locating the position of the corner:

Found Clay Tile is accepted as a careful and faithful perpetuation of the position of the original corner. Placed Harrison monument over existing Clay Tile and monument box over. Accessories:

- Nail & Tab in E. Face 12" Maple N. 07° E. 56.75'
- Nail & Tab in S.E. Face 20" Oak N. 43° E. 39.40'
- Nail & Tab in W. Face 20" Oak S. 20° W. 18.82'
- Nail & Tab in N. Face 20" Oak S. 78° W. 83.20'

Signed by Allen H. McMachen

Date 3/22/95

Surveyor's Michigan License No. 16935