



LC-000027  
 Page: 1 of 1  
 09/17/1999 03:11P  
 Bk-2 Pg-480

PREIN & NEUHOF

LANDCOR-Kalamazoo

**LAND CORNER RECORDATION CERTIFICATE**  
**Filing Requirement of Act 74, Mich. P.A. 1970**

For corners in Schoolcraft Twp.


**SURVEY &  
 REMONUMENTATION**

**FEB 08 2000**

**SECTION**

Register of Deeds Stamp & File Number

<u>Kalamazoo</u> (County)	Located in:	Corner Code #
1. Public Land Survey	T <u>4</u> S R <u>11</u> W	<u>I-06</u>
	T _____ R _____	_____
	T _____ R _____	_____
	T _____ R _____	_____
2. Property Controlling in Section	S _____ T _____ R _____	_____
	S _____ T _____ R _____	_____
3. Miscellaneous Property in Sec.	S _____ T _____ R _____	_____
	S _____ T _____ R _____	_____
4. Lot No. _____, Recorded Plat _____		
5. Private Claims		

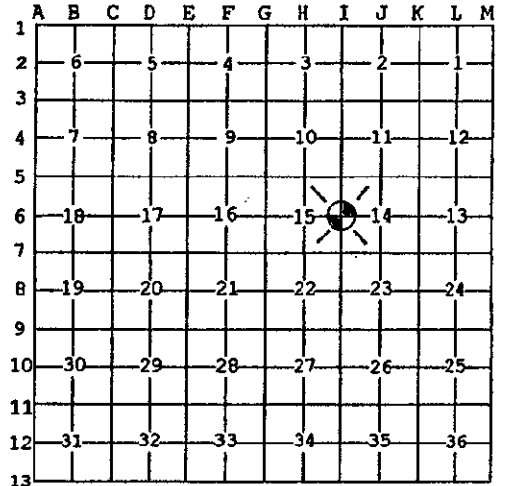

I, Robert E. Snell, in a field survey on June 25, 1999 do hereby state that under requirements of P.A. 74, Michigan P.A. of 1970, the corner points mentioned in lines 1 and 2 above were in conformance with regulations and rules therefore as required in the current manual of survey instructions of the United States Department of the Interior, Bureau of Land Management or by a decree of a Court of Law and/or that the corner points mentioned in lines 3, 4 and 5 above were in conformance with the rules of the Michigan Board of Land Surveyors or by a Decree of a Court of Law; established, re-established, monumented, recovered, found as expressed below:

NOTE: Not more than 2 corners, all in the same town and range, may be recorded on this certificate.

**A. Description of original monument and accessories and/or subsequent restoration:**

- 1826: United States Government Surveyors, R. Clark, Jr.; set 1/4 post - in prairie and raised mound.
- 1881: E. Strong, Deputy County Surveyor; corner lost. Bisected Section line and placed a drilled stone with a stone N. 45° E. 70 lks. and a stone S. 45° E. 70 lks.
- 1889: F. Hodgman, County Surveyor; found stone of re-survey and side stone N.E. 70 lks. In place - set post.

**B. Description of corner evidence found and/or method applied in restoring or reestablishing corner:**

- 1953: Louis Kingscott, Engineer; Railroad spike over tile set flush with paving grade at intersection of Portage Road and "VW" Avenue.  
 15° W. Cherry N. 10°-30' E. 120.20' Conc. Triangular Marker S. 32°-25' E. 65.40'  
 15° W. Cherry S. 15°-15' W. 122.7' Wood Street Marker N. 32°-45' W. 47.10'
- 1963, 1964 & 1972: Surveys of Wilkins & Wheaton Engr. Co. and Acro Engineering; used Railroad spike.
- 1999: Found Railroad spike 6" below PK Nail at surface. Dug a hole to 6 ft. and did not find tile.

**C. Description of monument for corner and accessories established to perpetuate locating the position of the corner:**

I-06: West 1/4 post, Section 14, T. 4 S., R. 11 W., ratified by the Kalamazoo County Remonumentation Program Peer Group on August 19, 1999 and is accepted as the best available evidence of the position of the original corner. Found small Railroad spike as placed in 1953 survey of L. Kingscott, Engineer for the plat of Tremblay Acres recorded in L-20, P-03 of Plats in 1953. Placed 20" Harrison monument in monument box in place of Railroad spike.

PK Nail in West Face	Guy Pole	N. 41°-31' W.	56.06'
PK nail in North Face	Telephone Pole	N. 68°-33' W.	76.31'
PK Nail in East Face	Guy Pole	S. 44°-58' E.	63.00'
PK Nail in Southwest Face	Power Pole	S. 43°-08' E.	84.11'
PK Nail in East Face	Light Pole	S. 21°-52' E.	91.34'

Signed by Robert E. Snell Date 9-16-99  
 Surveyor's Michigan License No. 9734

**RATIFIED**  
**BY KALAMAZOO COUNTY**  
**REMONUMENTATION**  
**PEER GROUP**  
 8-19-999