

SURVEY & REMONUMENTATION

MAY 16 1996

STATE OF MICHIGAN
COUNTY OF KALAMAZOO
RECEIVED FOR RECORD

LAND CORNER RECORDATION CERTIFICATE
Filing Requirement of Act 74, Mich. P.A. 1970

'96 MAR 13 PM 3 42

For corners **COMMISSION**
Kalamazoo
(County)
Schoolcraft Twp.

Located In: Corner Code #

1. Public Land Survey	T 4 S. R 11 W.	L-05
	T _____ R _____	_____
	T _____ R _____	_____
	T _____ R _____	_____
2. Property Controlling in Section	S _____ T _____ R _____	_____
	S _____ T _____ R _____	_____
3. Miscellaneous Property in Section	S _____ T _____ R _____	_____
	S _____ T _____ R _____	_____

James D. Young
CLERK-REGISTER


LIBER 1 1448

Register of Deeds Stamp & File Number

4. Lot No. _____, Recorded Plat _____
5. Private Claims _____

I, Robert E. Snell, in a field survey on January 26, 19 96, do hereby certify that under requirements of P.A. 74, Michigan P.A. of 1970, the corner points mentioned in lines 1 and 2 above were in conformance with regulations and rules therefore as required in the current manual of survey instructions of the United States Department of the Interior, Bureau of Land Management or by a decree of a Court of Law and/or that the corner points mentioned in lines 3, 4 and 5 above were in conformance with the rules of the Michigan Board of Professional Surveyors or by a Decree of a Court of Law; established, re-established, monumented, re-monumented, recovered, found as expressed below:

NOTE: Not more than 4 corners, all in the same town and range, may be recorded on this certificate.

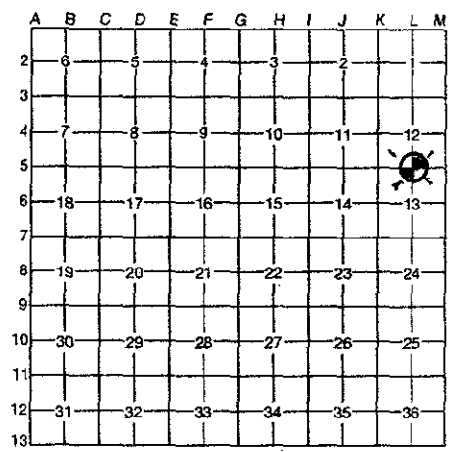

A. Description of original monument and accessories and/or subsequent restoration:

- 1826: Original United States Government Surveyors; set 1/4 Section post.
 W. Oak 11" North 113 lks.
 Y. Oak 24" S. 49° E. 149 lks.
- 1889: F. Hodgman, County Surveyor; found stone and bearing tree of former survey Northeast in place. Set post.
 Butternut N. 15°+ E. 39 lks.

B. Description of corner evidence found and/or method applied in restoring or reestablishing corner:

- 1942: Wilkins & Wheaton Engr. Co.; found tile 6" below surface, fence in line to East
 Southwest corner of House Northeast 42.68'
 12" Maple S. 45° W. 68.70'
 15" Butternut N. 15° W. 25.25'
 10" Walnut N. 60° W. 76.1'
- 1972: Allen McMachen, R.L.S. #16935; L.C.R.C. L-1, P-57 - Set iron over tile.
 10" Walnut N. 40° W. 46.23'
 Corner foundation N. 03° E. 42.7'
 12" Maple East 44.33'

R. E. Snell
RATIFIED BY KALAMAZOO COUNTY REMONUMENTATION PEER GROUP
2-15-96

1996: Found 1/2" x 8" iron over tile from 2 witnesses.

C. Description of monument for corner and accessories established to perpetuate locating the position of the corner:

L-05: South 1/4 post Section 12, T. 4 S., R. 11 W., Ratified by Kalamazoo County Remonumentation Program Peer Group on February 15, 1996 and is accepted as a careful and faithful perpetuation of the position of the original corner. Found 3" round tile with "x" on top as set by F. Hodgman, County Surveyor in 1889 Remonumentation Survey. Placed a remonumentation sleeve over tile.

- In center line of Roads West and South
 Exist Nail/Tab in Southwest side Power Pole N. 62° W. 61.74'
 PK Nail in Southwest side 18" Walnut N. 40° W. 46.05'
 Southwest corner of house foundation N. 14° E. 42.63'
 Exist Nail/Tab in North side Street light pole S. 80° W. 27.14'

Signed by Robert E. Snell

Date 3-12-96

Surveyor's Michigan License No. 9734