SURVEY & REMONUMENTATION

JUL 2 3 1997

COMMISSION

LIBER 2 PAGE 101

STATE OF MICHIGAN
COUNTY OF KALAMAZOO
RECEIVED FOR RECORD
'96 DEC 31 PM 2 35
CLERK-REGISTER

Register of Deeds Stamp & File Number

LAND CORNER RECORDATION CERTIFICATE

Filing Requirement of Act 74, Mich. P.A. 1970

For corners in Schoolcraft Township
Kalamazoo (County)

	Located In:	Corner Code #
1. Public Land Survey	T 4S. R 11W.	L-9
	T ____ R ____	
	T ____ R ____	
	T ____ R ____	
2. Property Controlling	S ____ T ____ R ____	
in Section	S ____ T ____ R ____	
3. Miscellaneous	S ____ T ____ R ____	
Property in Section	S ____ T ____ R ____	

4. Lot No. _____, Recorded Plat _____
5. Private Claims _____

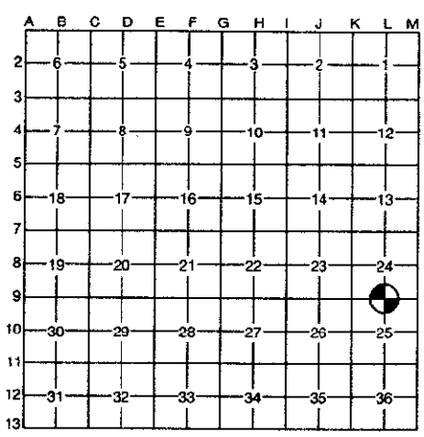

I, Allen H. McMachen, in a field survey on May 7, 19 96, do hereby certify that under requirements of P.A. 74, Michigan P.A. of 1970, the corner points mentioned in lines 1 and 2 above were in conformance with regulations and rules therefore as required in the current manual of survey instructions of the United States Department of the Interior, Bureau of Land Management or by a decree of a Court of Law and/or that the corner points mentioned in lines 3, 4 and 5 above were in conformance with the rules of the Michigan Board of Professional Surveyors or by a Decree of a Court of Law; established, re-established, monumented, re-monumented, recovered, found as expressed below:

NOTE: Not more than 4 corners, all in the same town and range, may be recorded on this certificate.

A. Description of original monument and accessories and/or subsequent restoration:

1826 - Robert Clark, Jr., D.S., Set quarter Section post, W. Oak 16" S. 21° E. 58 lks, Tamarack 6" N. 17½° E., 18 lks.

1889 - F. Hodgman, C.S., Found stake N. 21° W. 58 lks. from stump of W. Oak bearing tree and S. 17½° W. 18 lks. from stump of Tamarack bearing tree. Set post Tamarack 2 N. 78° W. 43¼ lks., Stone covered up South 50 lks.

B. Description of corner evidence found and/or method applied in restoring or reestablishing corner:

Found form pin in monument box. Removed pin and box and excavated, found clay tile 2.5' below grade and directly below form pin.

RATIFIED
BY KALAMAZOO COUNTY
REMONUMENTATION
PEER GROUP
6/20/1996

STATE OF MICHIGAN
ALLEN H. McMACHEN
PROFESSIONAL SURVEYOR
No. 16935
LICENSED PROFESSIONAL SURVEYOR

C. Description of monument for corner and accessories established to perpetuate locating the position of the corner:

Clay tile was accepted as a careful and faithful perpetuation of the position of the original corner. Placed Harrision Monument over clay tile and monument box, Accessories:

"PK" Nail in South Side Power Pole S. 85° E. 270.23'
"PK" Nail in East side Power Pole N. 25° W. 22.62'
"PK" Nail in Northeast side 12" Elm S. 63° E. 55.91'
"PK" Nail in Southeast side Maple S. 60° W. 159.83'

Signed by Allen H McMachen Date 12/31/96

Surveyor's Michigan License No. 16935

FORM APPROVED BY MICHIGAN STATE BOARD OF PROFESSIONAL SURVEYORS, JAN. 28, 1971
REVISED MAY 14, 1975
REVISED JAN., 1983