

7  
2  
APR 01 1996  
COMMISSION

LAND CORNER RECORDATION CERTIFICATE  
Filing Requirement of Act 74, Mich. P.A. 1970

STATE OF MICHIGAN  
COUNTY OF KALAMAZOO  
RECEIVED FOR RECORD  
'95 DEC 27 AM 10 38

For corners in Kalamazoo (County) Located In: \_\_\_\_\_ Corner Code # \_\_\_\_\_  
Texas Twp.

1. Public Land Survey T 3 S R 12 W \_\_\_\_\_ A-13  
 Common with N.W. T \_\_\_\_\_ R \_\_\_\_\_ \_\_\_\_\_  
 Cor. Section 16, T 4 S, R 12 W T \_\_\_\_\_ R \_\_\_\_\_  
Prairie Ronde Twp. T 4 S R 12 W \_\_\_\_\_ (A-1) ✓  
 2. Property Controlling S \_\_\_\_\_ T \_\_\_\_\_ R \_\_\_\_\_  
 in Section S \_\_\_\_\_ T \_\_\_\_\_ R \_\_\_\_\_  
 3. Miscellaneous S \_\_\_\_\_ T \_\_\_\_\_ R \_\_\_\_\_  
 Property in Sec. S \_\_\_\_\_ T \_\_\_\_\_ R \_\_\_\_\_

*James E. Boynton*  
CLERK-REGISTER

LIBER 1 1420

Register of Deeds Stamp & File Number

4. Lot No. \_\_\_\_\_, Recorded Plat \_\_\_\_\_  
5. Private Claims \_\_\_\_\_  
**RATIFIED**  
**BY KALAMAZOO COUNTY**  
**REMONUMENTATION**  
**PEER GROUP**  
 4-20-95

	A	B	C	D	E	F	G	H	I	J	K	L	M
2	6	5	4	3	2								
3													
4	7	8	9	10	11	12							
5													
6	18	17	16	15	14	13							
7													
8	19	20	21	22	23	24							
9													
10	30	29	28	27	26	25							
11													
12	31	32	33	34	35	36							

I, James E. Boynton in a field survey on July 1, 1994, do hereby certify that under requirements of P.A. 74, Michigan P.A. of 1970, the corner points mentioned in lines 1 and 2 above were in conformance with regulations and rules therefore as required in the current manual of survey instructions of the United States Department of the Interior, Bureau of Land Management or by a decree of a Court of Law and/or that the corner points mentioned in lines 3, 4 and 5 above were in conformance with the rules of the Michigan Board of Land Surveyors or by a Decree of a Court of Law; established, re-established, monumented, re-monumented, recovered, found as expressed below:

NOTE: Not more than 4 corners, all in the same town and range, may be recorded on this certificate.


A. Description of original monument and accessories and/or subsequent restoration:  
 1827, original corner established by William Brookfield, D.S.  
 1900, large stone found by W.H. Goss, C.S.  
 1958, pipe set over stone by W.P. Smith, C.S.  
 1992, rebar in mon. box found by G. Mitchell

B. Description of corner evidence found and/or method applied in restoring or reestablishing corner:  
 Found iron, pipe and stone from witnesses.  
 Accepted as best evidence of original corner.

Set standard VanBuren County remonumentation marker as directed by Van Buren Peer Group on June 29, 1994 and subsequently accepted

C. Description of monument for corner and accessories established to perpetuate locating the position of the corner:

by the Kalamazoo County Peer Group on ~~September 21~~, 1995.  
~~April 20~~  
 T.C.B. N. 45° W. 48.74' to C  
 20" Walnut East 39.15' to nail  
 9" Walnut N 35° E. 49.58' to nail  
 Twin 9" Walnut S. 50° E. 52.05' to nail

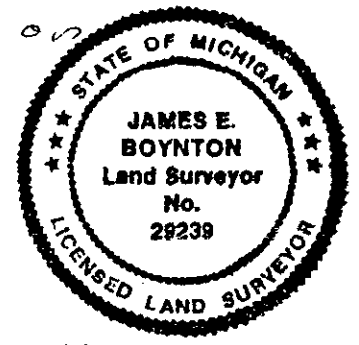

Signed by James E. Boynton Date Dec. 17, 1995  
 Surveyor's Michigan License No. 29239