

APR 11 1996

COMMISSION

LAND CORNER RECORDATION CERTIFICATE
Filing Requirement of Act 74, Mich. P.A. 1970

STATE OF MICHIGAN
COUNTY OF KALAMAZOO
RECEIVED FOR RECORD

'95 DEC 18 PM 2 28

James DeYoung
CLERK-REGISTER

LIBER 1 1414

Register of Deeds Stamp & File Number

For corners in

| | | |
|--|-------------------------|---------------|
| <u>Kalamazoo</u> (County) | Located in: | Corner Code # |
| 1. Public Land Survey | T 4 S. R 12 W. | A3 |
| | T _____ R _____ | _____ |
| | T _____ R _____ | _____ |
| | T _____ R _____ | _____ |
| 2. Property Controlling in Section | S _____ T _____ R _____ | _____ |
| | S _____ T _____ R _____ | _____ |
| 3. Miscellaneous Property in Sec. | S _____ T _____ R _____ | _____ |
| | S _____ T _____ R _____ | _____ |
| 4. Lot No. <u>N/A</u> , Recorded Plat <u>N/A</u> | | |
| 5. Private Claims _____ | | |

| A | B | C | D | E | F | G | H | I | J | K | L | M |
|----|----|----|----|----|----|----|---|---|---|---|---|---|
| 2 | 6 | 5 | 4 | 3 | 2 | 1 | | | | | | |
| 3 | | | | | | | | | | | | |
| 4 | 7 | 8 | 9 | 10 | 11 | 12 | | | | | | |
| 5 | | | | | | | | | | | | |
| 6 | 18 | 17 | 16 | 15 | 14 | 13 | | | | | | |
| 7 | | | | | | | | | | | | |
| 8 | 19 | 20 | 21 | 22 | 23 | 24 | | | | | | |
| 9 | | | | | | | | | | | | |
| 10 | 30 | 29 | 28 | 27 | 26 | 25 | | | | | | |
| 11 | | | | | | | | | | | | |
| 12 | 31 | 32 | 33 | 34 | 35 | 36 | | | | | | |
| 13 | | | | | | | | | | | | |

I, GREGORY N. JENSEN, in a field survey on 07/17, 19 93, do hereby certify that under requirements of P.A. 74, Michigan P.A. of 1970, the corner points mentioned in lines 1 and 2 above were in conformance with regulations and rules therefore as required in the current manual of survey instructions of the United States Department of the Interior, Bureau of Land Management or by a decree of a Court of Law and/or that the corner points mentioned in lines 3, 4 and 5 above were in conformance with the rules of the Michigan Board of Land Surveyors or by a Decree of a Court of Law, established, re-established, monumented, re-monumented, recovered, found as expressed below:

NOTE: Not more than 4 corners, all in the same town and range, may be recorded on this certificate.

A. Description of original monument and accessories and/or subsequent restoration:

- A3 NORTHWEST CORNER SEC. 7, T.4 S., R.12 W.
- STRONG - FEB. 21, 1906 FOUND STONE AND CROCKERY NORTH EAST COR. SEC. 12 PORTER TWP. 30.93' (GOV = 31.02).
 - WILKINS AND WEATON - FOUND STONE AND BRICK 20" DOWN. LIGHT POLE NE. 66.4'
RAILROAD IRON SW. 48.55' IRON FENCE POST N. 80' W. 31.0'
12" BLACK WALNUT SE. 45.15' HICKORY 12" N. 20' W. 77.05'
 - KESTER - FOUND IRON OVER STONE RAILROAD RAIL S 40' W. 48.55'.
POWER POLE N 40' W. 41.20'
POWER POLE N 60' E. 51.50'

B. Description of corner evidence found and/or method applied in restoring or reestablishing corner:


- A3 NORTHWEST CORNER SEC. 7, T.4 S., R.12 W.
- FOUND IRON IN MONUMENT BOX OVER STONE PER KESTER 1972 LCRC L1, P205.

RATIFIED
BY KALAMAZOO COUNTY
REMONUMENTATION
PEER GROUP
11-16-95
R.E.S.

C. Description of monument for corner and accessories established to perpetuate locating the position of the corner:

A3 NORTHWEST CORNER SEC. 7, T.4 S., R.12 W. RATIFIED BY KALAMAZOO COUNTY REMONUMENTATION PROGRAM PEER GROUP ON NOVEMBER 16 1995. PLACED HARRISON IN MONUMENT BOX OVER STONE AND IS ACCEPTED AS A CAREFUL AND FAITHFUL PERPETUATION OF THE POSITION OF THE ORIGINAL CORNER.

- TELE. RISER S 45' W. - 52.91'
- POWERPOLE S 25' E. - 93.80'
- POWERPOLE N 45' E. - 52.95'
- GUY POLE N 45' W. - 41.40'

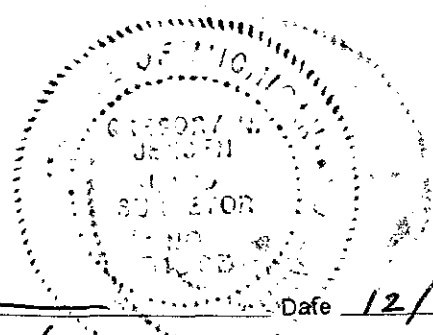

Signed by Gregory N. Jensen Date 12/10/95

Surveyor's Michigan License No. 12/10/95-31593