

APR 6 1 1996

COMMISSION

STATE OF MICHIGAN
COUNTY OF KALAMAZOO
RECEIVED FOR RECORD

LAND CORNER RECORDATION CERTIFICATE
Filing Requirement of Act 74, Mich. P.A. 1970

95 DEC 18 PM 2 28

For corners in

Kalamazoo (County) Located In: Corner Code #

1. Public Land Survey	T <u>4</u> S. R. <u>12</u> W.	A5
	T _____ R _____	_____
	T _____ R _____	_____
	T _____ R _____	_____
2. Property Controlling in Section	S _____ T _____ R _____	_____
	S _____ T _____ R _____	_____
3. Miscellaneous Property in Sec.	S _____ T _____ R _____	_____
	S _____ T _____ R _____	_____

4. Lot No. N/A, Recorded Plat N/A

5. Private Claims _____

James D. Young
CLERK-REGISTER

LIBER 1 1415

Register of Deeds Stamp & File Number

I, GREGORY N. JENSEN, in a field survey on 07/17, 19 93, do hereby certify that under requirements of P.A. 74, Michigan P.A. of 1970, the corner points mentioned in lines 1 and 2 above were in conformance with regulations and rules therefore as required in the current manual of survey instructions of the United States Department of the Interior, Bureau of Land Management or by a decree of a Court of Law and/or that the corner points mentioned in lines 3, 4 and 5 above were in conformance with the rules of the Michigan Board of Land Surveyors or by a Decree of a Court of Law; established, re-established, monumented, re-monumented, recovered, found as expressed below:

NOTE: Not more than 4 corners, all in the same town and range, may be recorded on this certificate.

A	B	C	D	E	F	G	H	I	J	K	L	M
2	6	5	4	3	2	1						
3												
4	7	8	9	10	11	12						
5												
6	13	17	16	15	14	13						
7												
8	19	20	21	22	23	24						
9												
10	30	29	28	27	26	25						
11												
12	31	32	33	34	35	36						
13												

A. Description of original monument and accessories and/or subsequent restoration:

A5 SOUTHWEST CORNER SEC. 7, T.4 S., R.12 W.

- GLO SURVEY - WHITE OAK 9", N 15° E. 20 LKS (13.2'). WHITE OAK 16", N 48° E. 70 LKS (46.2').
- HODGEMAN - SET STONE WITH DRILL HOLE 20 LKS (13.2') NORTH OF CORRESPONDING CORNER OF TOWNSHIP WEST (1 WITNESS STANDING AND STUMP OF THE OTHER PORTER CORNER).
- WILKINS AND WEATON 48" WHITE OAK, S 15° W. 19.3'
12" MAPLE, S 45° E. 50.0'
FENCE CORNER, N 70° E. 30.6'

B. Description of corner evidence found and/or method applied in restoring or reestablishing corner:

A5 SOUTHWEST CORNER SEC. 7, T.4 S., R.12 W.

FOUND 3/4" PIPE OVER 1" ROD. ROD 2' DEEP. FOUND IRON • SOUTHEAST COR. PORTER TWP. 12.91' SOUTH (GOV. 13.2').


RATIFIED
BY KALAMAZOO COUNTY
REMONUMENTATION
PEER GROUP
11-16-95

R. Jensen

C. Description of monument for corner and accessories established to perpetuate locating the position of the corner:

A5 SOUTHWEST CORNER SEC. 7, T.4 S., R.12 W. RATIFIED BY KALAMAZOO COUNTY REMONUMENTATION PROGRAM PEER GROUP ON NOVEMBER 16, 1995. PLACED HARRISON IN MONUMENT BOX OVER ROD AND IS ACCEPTED AS A CAREFUL AND FAITHFUL PERPETUATION OF THE POSITION OF THE ORIGINAL CORNER.

- FENCE POST N 75° W. - 40.9' (RR TIE)
- FENCE POST N 75° E. - 31.77' (RR TIE)
- 40" MAPLE S 45° E. - 50.43'
- POWER POLE S 70° W. - 83.40'

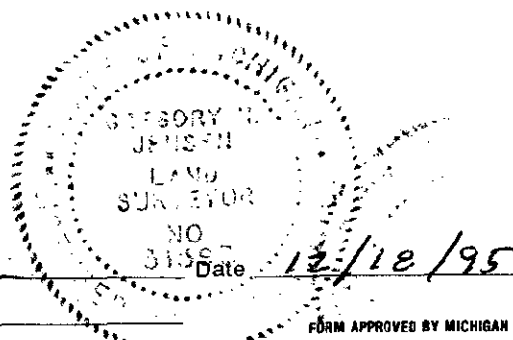

Signed by Gregory N. Jensen
Surveyor's Michigan License No. 31593