

SURVEY & REMONUMENTATION

FEB 18 1994

COMMISSION

**KALAMAZOO COUNTY - REMONUMENTATION
LAND CORNER RECORDATION CERTIFICATE**

Filing Requirement of Act 74, Mich. P.A. 1970

STATE OF MICHIGAN
COUNTY OF KALAMAZOO

RECEIVED FOR RECORD
'93 NOV 11 AM 8 54

For corners in


<u>Kalamazoo</u> <small>(County)</small>	Located In:	Corner Code -#
1. Public Land Survey	T <u>4S</u> R <u>12W</u>	C-3
	T _____ R _____	SW Cor.
	T _____ R _____	Sec. 5
	T _____ R _____	Prairie Ronde
2. Property Controlling in Section	S _____ T _____ R _____	Township _____
	S _____ T _____ R _____	
3. Miscellaneous Property in Sec.	S _____ T _____ R _____	
	S _____ T _____ R _____	

James D. Spang
CLERK-REGISTER

LIBER 1 PG 1023
Register of Deeds Stamp & File Number

4. Lot No. _____, Recorded Plat _____
5. Private Claims _____

I, Thomas W. Chettleburgh, in a field survey on October 15, 1993, do hereby certify that under requirements of P.A. 74, Michigan P.A. of 1970, the corner points mentioned in lines 1 and 2 above were in conformance with regulations and rules therefore as required in the current manual of survey instructions of the United States Department of the Interior, Bureau of Land Management or by a decree of a Court of Law and/or that the corner points mentioned in lines 3, 4 and 5 above were in conformance with the rules of the Michigan Board of Land Surveyors or by a Decree of a Court of Law, established, re-established, monumented, re-monumented, recovered, found as expressed below:

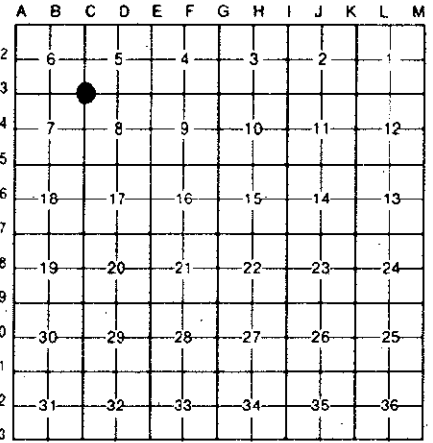

NOTE: Not more than 4 corners, all in the same town and range, may be recorded on this certificate.

A. Description of original monument and accessories and/or subsequent restoration:

**Strong 1901, Found Stone
Kalamazoo County Witnesses, iron
W. Smith 1977, Found 5/8" iron, set Monument Box**


B. Description of corner evidence found and/or method applied in restoring or reestablishing corner:

**Found 5/8" iron in Monument Box in centerline roads East, West and North
Checked W. Smith 1977 witnesses
Replace 5/8" iron with 4" X 20" Harrison Monument**

**RATIFIED
BY KALAMAZOO COUNTY
REMONUMENTATION
PEER GROUP**

C. Description of monument for corner and accessories established to perpetuate locating the position of the corner:

4" X 20" Harrison Monument in Monument Box					
Spike	SE	side	Power Pole	N55°E	58.91'
Spike	S	side	15" Walnut	N75°E	87.21'
Spike	E	side	Power Pole	S1°E	36.17'
Spike	S	side	9" Mulberry	N80°W	166.69'
Spike	E	side	21" W. Cherry	N10°W	74.17'

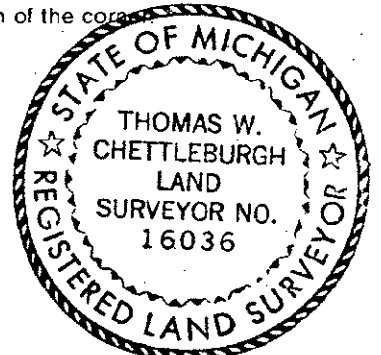

Signed by Thomas W. Chettleburgh Date November 8, 1993
Surveyor's Michigan License No. 16036