APR 0 1 1995
COMMISSION

STATE OF MICHIGAN
COUNTY OF KALAMAZOO
RECEIVED FOR RECORD
'95 DEC 18 PM 2 28
CLERK-REGISTER

LAND CORNER RECORDATION CERTIFICATE

Filing Requirement of Act 74, Mich. P.A. 1970

For corners in

Kalamazoo (County)

	Located in:	Corner Code #
1. Public Land Survey	T 4 S. R 12 W.	C4
	T ___ R ___	
	T ___ R ___	
	T ___ R ___	
2. Property Controlling	S ___ T ___ R ___	
in Section	S ___ T ___ R ___	
3. Miscellaneous	S ___ T ___ R ___	
Property in Sec.	S ___ T ___ R ___	

Register of Deeds Stamp & File Number

LIBER 1 1412

4. Lot No. N/A, Recorded Plat N/A
5. Private Claims

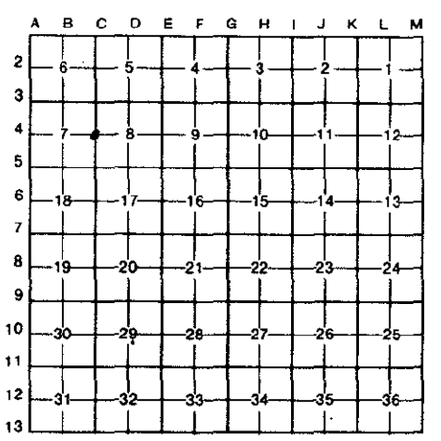

I, GREGORY N. JENSEN, in a field survey on 07/17, 19 93, do hereby certify that under requirements of P.A. 74, Michigan P.A. of 1970, the corner points mentioned in lines 1 and 2 above were in conformance with regulations and rules therefore as required in the current manual of survey instructions of the United States Department of the Interior, Bureau of Land Management or by a decree of a Court of Law and/or that the corner points mentioned in lines 3, 4 and 5 above were in conformance with the rules of the Michigan Board of Land Surveyors or by a Decree of a Court of Law; established, re-established, monumented, re-monumented, recovered, found as expressed below:

NOTE: Not more than 4 corners, all in the same town and range, may be recorded on this certificate.

A. Description of original monument and accessories and/or subsequent restoration:

C4 EAST 1/4 POST SEC. 7, T.4 S., R.12 W.

1. GLO SURVEY - B. 11", S 42° E. 30 LKS (19.8')
   A. 8", N 45° W. 21 LKS (13.86)

2. HODGEMAN - POST IN FENCE, STUMP OF ONE GOVERNMENT WITNESS AND TRACES OF THE OTHER REMAINING, LARGE TRIANGULAR SPLIT OAK POST.

B. Description of corner evidence found and/or method applied in restoring or reestablishing corner:

C4 EAST 1/4 POST SEC. 7, T.4 S., R.12 W.

FOUND 1 1/2" PIPE WITH STONE AND BRICK AROUND.

RATIFIED BY KALAMAZOO COUNTY REMONUMENTATION PEER GROUP
11-16-95
R.L.S.

C. Description of monument for corner and accessories established to perpetuate locating the position of the corner:

C4 EAST 1/4 POST SEC. 7, T.4 S., R.12 W. RATIFIED BY KALAMAZOO COUNTY REMONUMENTATION PROGRAM PEER GROUP ON NOVEMBER 16 1995. PLACED HARRISON MONUMENT IN PLACE OF 1 1/2" PIPE AND IS ACCEPTED AS A CAREFUL AND FAITHFUL PERPETUATION OF THE POSITION OF THE ORIGINAL CORNER.

10" ELM N 45° W. - 8.10'
36" DBL. ELM W. - 22.23'
9" ELM S 5° W. - 29.92'
12" WALNUT N 20° W. - 38.35'

GREGORY N. JENSEN LAND SURVEYOR

Signed by Gregory N. Jensen Date 12/18/95

Surveyor's Michigan License No. 31593

FORM APPROVED BY MICHIGAN STATE BOARD OF LAND SURVEYORS, JAN. 28, 1971
REVISED MAY 14, 1975
REVISED JAN., 1983