

SURVEY & REMONUMENTATION

FEB 18 1994

COMMISSION

**KALAMAZOO COUNTY REMONUMENTATION
LAND CORNER RECORDATION CERTIFICATE
Filing Requirement of Act 74, Mich. P.A. 1970**

STATE OF MICHIGAN
COUNTY OF KALAMAZOO
RECEIVED FOR RECORD
'93 NOV 11 AM 8 54

For corners in

| | | |
|---|--------------------------|---------------------|
| <u>Kalamazoo</u> <small>(County)</small> | Located In: | Corner Code #: |
| 1. Public Land Survey | T <u>4S</u> R <u>12W</u> | D-1 |
| | T _____ R _____ | N 1/4 Cor. _____ |
| | T _____ R _____ | Sec. <u>5</u> _____ |
| | T _____ R _____ | Prairie Ronde _____ |
| 2. Property Controlling in Section | S _____ T _____ R _____ | Township _____ |
| | S _____ T _____ R _____ | _____ |
| 3. Miscellaneous Property in Sec. | S _____ T _____ R _____ | _____ |
| | S _____ T _____ R _____ | _____ |

James G. Gump
CLERK-REGISTER

LIBER 1 PG 1018
Register of Deeds Stamp & File Number

4. Lot No. _____, Recorded Plat _____
5. Private Claims _____

| | | | | | | | | | | | | | |
|----|----|---|----|----|----|----|----|---|---|---|---|---|---|
| | A | B | C | D | E | F | G | H | I | J | K | L | M |
| 2 | 6 | | 5 | 4 | 3 | 2 | 1 | | | | | | |
| 3 | | | | | | | | | | | | | |
| 4 | 7 | | 8 | 9 | 10 | 11 | 12 | | | | | | |
| 5 | | | | | | | | | | | | | |
| 6 | 18 | | 17 | 16 | 15 | 14 | 13 | | | | | | |
| 7 | | | | | | | | | | | | | |
| 8 | 19 | | 20 | 21 | 22 | 23 | 24 | | | | | | |
| 9 | | | | | | | | | | | | | |
| 10 | 30 | | 29 | 28 | 27 | 26 | 25 | | | | | | |
| 11 | | | | | | | | | | | | | |
| 12 | 31 | | 32 | 33 | 34 | 35 | 36 | | | | | | |
| 13 | | | | | | | | | | | | | |

Thomas W. Chettleburgh, in a field survey on October 15, 1993, do hereby certify that under requirements of P.A. 74, Michigan P.A. of 1970, the corner points mentioned in lines 1 and 2 above were in conformance with regulations and rules therefore as required in the current manual of survey instructions of the United States Department of the Interior, Bureau of Land Management or by a decree of a Court of Law and/or that the corner points mentioned in lines 3, 4 and 5 above were in conformance with the rules of the Michigan Board of Land Surveyors or by a Decree of a Court of Law; established, re-established, monumented, re-monumented, recovered, found as expressed below:

NOTE: Not more than 4 corners, all in the same town and range, may be recorded on this certificate.

A. Description of original monument and accessories and/or subsequent restoration:

Strong 1901, Set stone at mean government measure (92 lks) West of South 1/4 Corner Section 32, T3S, R12W

B. Description of corner evidence found and/or method applied in restoring or reestablishing corner:


Corner not found, location in swamp with several feet of muck.
Set corner at mean government measure (92 lks/60.72') West of South 1/4 Corner Section 32, T3S, R12W, and on line with South 1/4 Corner Section 32 and NE Corner Section 5, T4S, R12W.
Set 4" X 30" Harrison Monument

**RATIFIED
BY KALAMAZOO COUNTY
REMONUMENTATION
PEER GROUP**

C. Description of monument for corner and accessories established to perpetuate locating the position of the corner:

4" X 30" Harrison Monument
S 1/4 Cor. Sec. 32, T3S, R12W, (4" Harrison Monument) East 60.72'

| | | | | | |
|-------|----|------|-------------|-------|--------|
| Spike | E | side | Tri-16" Ash | N10°E | 48.08' |
| Spike | N | side | 9" Birch | N75°E | 54.10' |
| Spike | SW | side | 36" Oak | S70°E | 36.47' |
| Spike | SW | side | 18" Hickory | S27°E | 25.13' |
| Spike | NW | side | 26" Maple | S45°W | 91.56' |

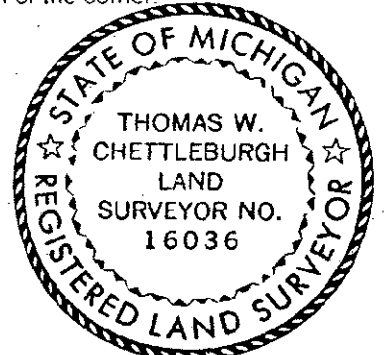

Signed by Thomas W. Chettleburgh Date November 8, 1993

Surveyor's Michigan License No. 16036