

**SURVEY &  
REMONUMENTATION**

FEB 18 1994

COMMISSION

**KALAMAZOO COUNTY REMONUMENTATION  
LAND CORNER RECORDATION CERTIFICATE  
Filing Requirement of Act 74, Mich. P.A. 1970**

STATE OF MICHIGAN  
COUNTY OF KALAMAZOO  
RECEIVED FOR RECORD  
'93 NOV 11 AM 8 54

For corners in

<u>Kalamazoo</u> (County)	Located In:	Corner Code #
1. Public Land Survey	T <u>4S</u> R <u>12W</u>	D-2
	T _____ R _____	Center
	T _____ R _____	Section 5
	T _____ R _____	Prairie Ronde
2. Property Controlling in Section	S _____ T _____ R _____	Township
	S _____ T _____ R _____	
3. Miscellaneous Property in Sec.	S _____ T _____ R _____	
	S _____ T _____ R _____	


*Janet P. Gump*  
CLERK-REGISTER

LIBER

1 PG 1021

Register of Deeds Stamp & File Number

4. Lot No. \_\_\_\_\_, Recorded Plat \_\_\_\_\_  
5. Private Claims \_\_\_\_\_

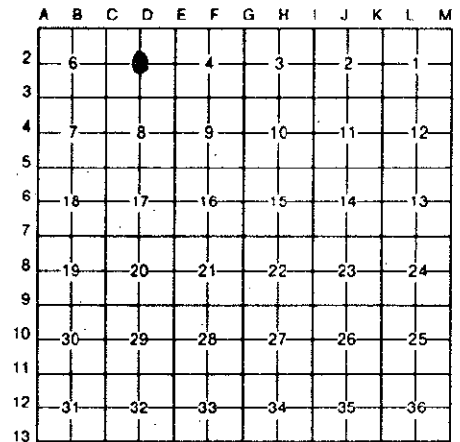

Thomas W.

Chettleburgh in a field survey on October 15 19 93

do hereby certify that under requirements of P.A. 74, Michigan P.A. of 1970, the corner points mentioned in lines 1 and 2 above were in conformance with regulations and rules therefore as required in the current manual of survey instructions of the United States Department of the Interior, Bureau of Land Management or by a decree of a Court of Law and/or that the corner points mentioned in lines 3, 4 and 5 above were in conformance with the rules of the Michigan Board of Land Surveyors or by a Decree of a Court of Law; established, re-established, monumented, re-monumented, recovered, found as expressed below:

**NOTE: Not more than 4 corners, all in the same town and range, may be recorded on this certificate.**

A. Description of original monument and accessories and/or subsequent restoration:

Strong 1901, Set stone and brick at intersection of 1/4 lines  
Kalamazoo County Witnesses, drilled stone  
W. Smith 1977, set 5/8" iron in E-W fence and on line between the South 1/4 Corner and property irons along N-S 1/4 line found North of the Center. (Strong in 1901 set 4 property corners along the N-S 1/4 line between Center & North 1/4 Corner)

B. Description of corner evidence found and/or method applied in restoring or reestablishing corner:

Found 5/8" iron set by W. Smith. Stone not found.  
5/8" iron measured 0.68' North & 0.64' East of intersection of 1/4 lines  
Set 4" X 30" Harrison Monument at intersection of 1/4 lines  
N 1/4 Corner Section 5 N00°15'03"E 2869.47'  
S 1/4 Corner Section 5 S00°15'03"W 2654.07'  
E 1/4 Corner Section 5 S89°59'43"E 2657.43'  
W 1/4 Corner Section 5 N89°59'43"W 2664.88'

**RATIFIED  
BY KALAMAZOO COUNTY  
REMONUMENTATION  
PEER GROUP**

C. Description of monument for corner and accessories established to perpetuate locating the position of the corner:

4" X 30" Harrison Monument

Spike	SE	side	34" Beech	N62°E	40.17'
Spike	S	side	7" Maple	S66°E	38.39'
Spike	SE	side	20" Beech	S33°W	34.93'
Spike	S	side	5" Maple	S65°W	26.37'
Spike	NE	side	12" Ash	N49°W	48.95'



Signed by *Thomas W. Chettleburgh* Date November 8, 1993

Surveyor's Michigan License No. 16036