

**SURVEY &
REMONUMENTATION**

FEB 18 1994

COMMISSION

**KALAMAZOO COUNTY REMONUMENTATION
LAND CORNER RECORDATION CERTIFICATE**
Filing Requirement of Act 74, Mich. P.A. 1970

STATE OF MICHIGAN
COUNTY OF KALAMAZOO
RECEIVED FOR RECORD
'93 NOV 11 AM 8 54

For corners in

<u>Kalamazoo</u> (County)	Located In:	Corner Code #:
1. Public Land Survey	T <u>4S</u> R <u>12W</u>	E-1
	T _____ R _____	NE Cor.
	T _____ R _____	Sec. 5
	T _____ R _____	Prairie Ronde
2. Property Controlling in Section	S _____ T _____ R _____	Township
	S _____ T _____ R _____	
3. Miscellaneous Property in Sec.	S _____ T _____ R _____	
	S _____ T _____ R _____	

James E. Young
CLERK-REGISTER

LIBER 1 PG 1019
Register of Deeds Stamp & File Number

4. Lot No. _____, Recorded Plat _____
5. Private Claims _____

A	B	C	D	E	F	G	H	I	J	K	L	M
2	6	5	4	3	2							
3												
4	7	8	9	10	11	12						
5												
6	18	17	16	15	14	13						
7												
8	19	20	21	22	23	24						
9												
10	30	29	28	27	26	25						
11												
12	31	32	33	34	35	36						
13												

I, Thomas W. Chettleburgh, in a field survey on October 15, 1993 do hereby certify that under requirements of P.A. 74, Michigan P.A. of 1970, the corner points mentioned in lines 1 and 2 above were in conformance with regulations and rules therefore as required in the current manual of survey instructions of the United States Department of the Interior, Bureau of Land Management or by a decree of a Court of Law and/or that the corner points mentioned in lines 3, 4 and 5 above were in conformance with the rules of the Michigan Board of Land Surveyors or by a Decree of a Court of Law: established, re-established, monumented, re-monumented, recovered, found as expressed below:

NOTE: Not more than 4 corners, all in the same town and range, may be recorded on this certificate.

A. Description of original monument and accessories and/or subsequent restoration:

Strong 1901, Found Stone
Kalamazoo County Witnesses
Hickory 8" N10°W 4.7'
Ash 18" N85°E 33.0'
Multi-Ash 4" S30°W 16.5'


B. Description of corner evidence found and/or method applied in restoring or reestablishing corner:

Found drilled stone
25" Ash S80°E 33.31'
Ash stump remnant SW 16.5'
Also found plow point (lying down) 2' East and 1.5' South of stone
Replaced stone with 4" X 30" Harrison Monument

**RATIFIED
BY KALAMAZOO COUNTY
REMONUMENTATION
PEER GROUP**

C. Description of monument for corner and accessories established to perpetuate locating the position of the corner:

4" X 30" Harrison Monument
SE Cor. Sec. 32, T3S, R12W, (4" Harrison Monument) East 45.54'
Spike N side 25" Ash S80°E 33.31'
Spike E side Tw. 26" Oak S2°E 85.11'
Spike S side 11" Oak N60°W 33.31'
Spike SW side 16" Oak N10°W 21.04'

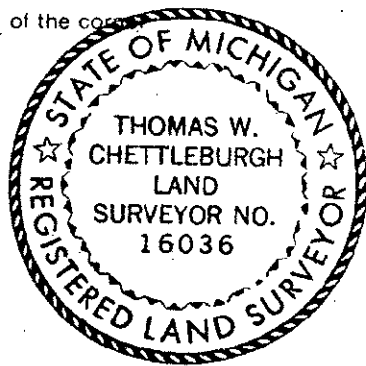

Signed by Thomas W. Chettleburgh Date November 8, 1993
Surveyor's Michigan License No. 16036