SURVEY & REMONUMENTATION

FEB 18 1994

COMMISSION

STATE OF MICHIGAN
COUNTY OF KALAMAZOO
RECEIVED FOR RECORD
'93 NOV 11 AM 8 54

CLERK-REGISTER

KALAMAZOO COUNTY REMONUMENTATION

LAND CORNER RECORDATION CERTIFICATE

Filing Requirement of Act 74, Mich. P.A. 1970

For corners in Kalamazoo (County)

	Located In:	Corner Code #
1. Public Land Survey	T 4S R 12W	E-3
	T ___ R ___	SE Cor.
	T ___ R ___	Sec. 5
	T ___ R ___	Prairie Ronde
2. Property Controlling	S ___ T ___ R ___	Township
in Section	S ___ T ___ R ___	
3. Miscellaneous	S ___ T ___ R ___	
Property in Sec.	S ___ T ___ R ___	

LIBER 1 PG 1025

Register of Deeds Stamp & File Number

4. Lot No. _____ , Recorded Plat _____
5. Private Claims _____

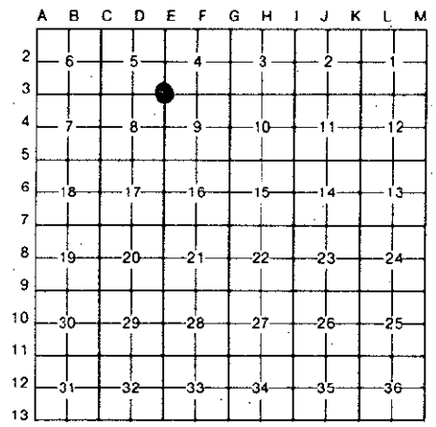

I, Thomas W. Chettleburgh, in a field survey on October 15, 19 93 do hereby certify that under requirements of P.A. 74, Michigan P.A. of 1970, the corner points mentioned in lines 1 and 2 above were in conformance with regulations and rules therefore as required in the current manual of survey instructions of the United States Department of the Interior, Bureau of Land Management or by a decree of a Court of Law and/or that the corner points mentioned in lines 3, 4 and 5 above were in conformance with the rules of the Michigan Board of Land Surveyors or by a Decree of a Court of Law; established, re-established, monumented, re-monumented, recovered, found as expressed below:

NOTE: Not more than 4 corners, all in the same town and range, may be recorded on this certificate.

A. Description of original monument and accessories and/or subsequent restoration:

Strong 1901, Found stone & crockery
Kalamazoo County Witnessess, iron in centerline road, N,S,E & W
Gove 1977, found stone & brick 2.5' deep, set iron & monument box

B. Description of corner evidence found and/or method applied in restoring or reestablishing corner:

Found iron in monument box in centerline road, N,S.,E & W
checked Gove 1977 witnesses
Replace iron with 4" X 20" Harrison Monument

RATIFIED BY KALAMAZOO COUNTY REMONUMENTATION PEER GROUP

C. Description of monument for corner and accessories established to perpetuate locating the position of the corner:

4" X 30" Harrison Monument in Monument Box

Spike	S	side	Power Pole	N82°E	163.82'
Spike	W	side	Power Pole	S 8°E	149.68'
Spike	E	side	Power Pole	S13°W	147.07'
Spike	N	side	Power Pole	N67°W	100.27'
Spike	E	side	Power Pole	N29°W	50.85'

STATE OF MICHIGAN
THOMAS W. CHETTLEBURGH
LAND SURVEYOR NO. 16036
REGISTERED LAND SURVEYOR

Signed by Thomas W. Chettleburgh Date November 8, 1993

Surveyor's Michigan License No. 16036

FORM APPROVED BY MICHIGAN STATE BOARD OF LAND SURVEYORS, JAN. 28, 1971
REVISED MAY 14, 1975
REVISED JAN., 1983