



LC-000058  
Page: 1 of 1  
10/29/1999 03:52P  
Bk-2 Pg-311

LAND CORNER RECORDATION CERTIFICATE  
Filing Requirement of Act 74, Mich. P.A. 1970

SURVEY &  
REMONUMENTATION

For corners in Prairie Ronde Twp.

FEB 08 2000


SECTION

<u>Kalamazoo</u> (County)	Located in:	Corner Code #
1. Public Land Survey	T <u>4</u> S R <u>12</u> W	<u>G-07</u>
	T <u>    </u> R <u>    </u>	<u>    </u>
	T <u>    </u> R <u>    </u>	<u>    </u>
	T <u>    </u> R <u>    </u>	<u>    </u>
2. Property Controlling in Section	S <u>    </u> T <u>    </u> R <u>    </u>	<u>    </u>
	S <u>    </u> T <u>    </u> R <u>    </u>	<u>    </u>
3. Miscellaneous Property in Sec.	S <u>    </u> T <u>    </u> R <u>    </u>	<u>    </u>
	S <u>    </u> T <u>    </u> R <u>    </u>	<u>    </u>
4. Lot No. _____, Recorded Plat _____		
5. Private Claims		

Register of Deeds Stamp & File Number

I, Robert E. Snell, in a field survey on May 22, 1999 do hereby state that under requirements of P.A. 74, Michigan P.A. of 1970, the corner points mentioned in lines 1 and 2 above were in conformance with regulations and rules therefore as required in the current manual of survey instructions of the United States Department of the Interior, Bureau of Land Management or by a decree of a Court of Law and/or that the corner points mentioned in lines 3, 4 and 5 above were in conformance with the rules of the Michigan Board of Land Surveyors or by a Decree of a Court of Law; established, re-established, monumented, recovered, found as expressed below:

NOTE: Not more than 2 corners, all in the same town and range, may be recorded on this certificate.

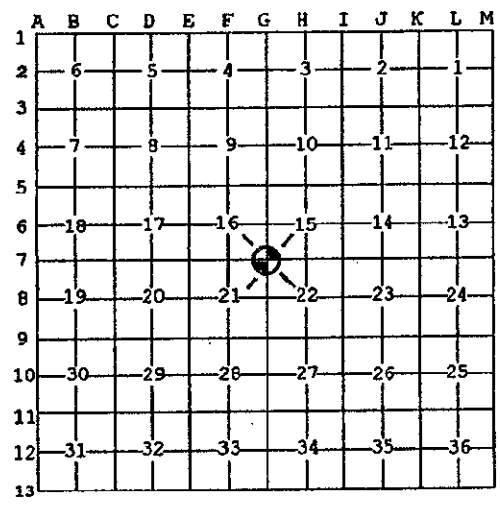

A. Description of original monument and accessories and/or subsequent restoration:

1829: United States Government Surveyors, E. Lythe; set post, corner to Sections 15, 16, 21 and 22.

Sugar 10"	S. 09° E.	30 lks.
Beech 18"	N. 67° W.	42 lks.

1873: E. Strong County Surveyor; Double Elm 10" N. 19° E. 28 (lks) and stone at stake hole.

B. Description of corner evidence found and/or method applied in restoring or reestablishing corner:

1919: Kalamazoo County Road Commission; stone, Southwest corner 15.

Hickory 12"	N. 58° E.	51.9'
Fence line	South	in line
Maple 15"	S. 28° W.	25.9'

1999: Found 1/2" x 18" iron under blacktop over stone (12" x 7" x 6") with small stones around and wood remains.

RATIFIED  
BY KALAMAZOO COUNTY  
REMONUMENTATION  
PEER GROUP  
9-9-1999  
*R. E. Snell*

C. Description of monument for corner and accessories established to perpetuate locating the position of the corner:

G-07: Southwest corner, Section 15, T. 4 S., R. 12 W., ratified by the Kalamazoo County Remonumentation Program Peer Group on September 9, 1999, and is accepted as a careful and faithful perpetuation of the position of the original corner. Found 12" x 7" x 6" Stone below 1/2" x 18" iron. The stone was set in 1873 survey by E. Strong, County Surveyor over stake hole. Placed 20" Harrison monument in monument box over stone.

Cut stone foundation	Southwest Corner of House	N. 14° E.	66.55'
PK Nail in West Side	34" Maple	N. 40° E.	38.91'
PK Nail in East Side	14" Elm	S. 03° W.	32.99'
PK Nail in East Side	22" Ash	S. 54° W.	47.39'
PK Nail in East Side	18" Locust	N. 04° E.	32.19'

Signed by Robert E. Snell  
Surveyor's Michigan License No. \_\_\_\_\_

Date 10/25/99