

SURVEY & REMONUMENTATION

1. FEB 26 1998

LAND CORNER RECORDATION CERTIFICATE
 Filing Requirement of Act 74, Mich. P.A. 1970

LIBER 2 PAGE 259


SECTION Prairie Ronde Township
 For corners in Kalamazoo (County)

Located In: Corner Code #

1. Public Land Survey	T	4S.	R	12W.	H-3
	T		R		
	T		R		
	T		R		
2. Property Controlling in Section	S	T	R		
	S	T	R		
3. Miscellaneous Property in Section	S	T	R		
	S	T	R		

STATE OF MICHIGAN
 COUNTY OF KALAMAZOO
 RECEIVED FOR RECORD
 97 DEC 22 PM 3 48
 J. J. Johnson
 CLERK - REGISTER
 Register of Deeds Stamp & File Number

- 4. Lot No. _____, Recorded Plat _____
- 5. Private Claims _____
- 6. IWM Job #30465-97

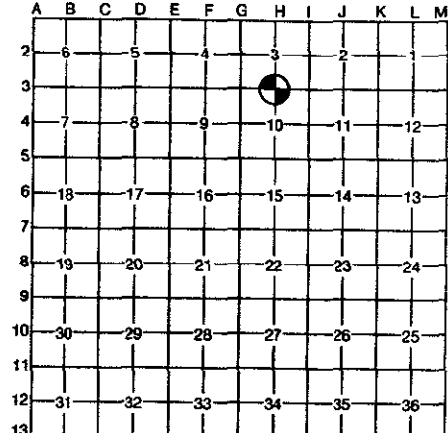

I, Allen H. McMachen, in a field survey on September 29, 1997, do hereby certify that under requirements of P.A. 74, Michigan P.A. of 1970, the corner points mentioned in lines 1 and 2 above were in conformance with regulations and rules therefore as required in the current manual of survey instructions of the United States Department of the Interior, Bureau of Land Management or by a decree of a Court of Law and/or that the corner points mentioned in lines 3, 4 and 5 above were in conformance with the rules of the Michigan Board of Professional Surveyors or by a Decree of a Court of Law; established, re-established, monumented, re-monumented, recovered, found as expressed below:

NOTE: Not more than 4 corners, all in the same town and range, may be recorded on this certificate.

A. Description of original monument and accessories and/or subsequent restoration:

- 1829 - E. H. Lytle, D.S., "Set quarter Section post in prairie and raised mound."
- 1873 - Ed Strong, C.S., "Stone at bisection-side stone."
- 1874 - F. Hodgman, Surveyor, "Stake & stones by Strong correct."
- 1895 - Ed Strong, C.S., "Set stone found stake hole, set new stake & brick B. Walnut 2" N. 01° E. 48 lks.."

B. Description of corner evidence found and/or method applied in restoring or reestablishing corner:

Found 3/8" iron in monument box. Removed iron & box and dug through 6" bituminous + 6" of road gravel finding 2nd road consisting of broken bituminous 2" thick + 6" road gravel + 8" virgin soil and found stone with drill hole, drill hole being directly under 3/8" iron location.

RATIFIED BY KALAMAZOO COUNTY REMONUMENTATION PEER GROUP
 11-20-1997

C. Description of monument for corner and accessories established to perpetuate locating the position of the corner:

Found stone is accepted as a careful and faithful perpetuation of the position of the original corner. Placed 20" Harrison Monument over drill hole and monument box over, Accessories:

- Nail & Tab in Southeasterly side U. Pole S. 35° W. 39.30'
- Placed iron rod N. 45° E. 33.87'
- Placed iron rod S. 45° E. 46.39'
- Placed iron rod S. 45° W. 45.50'
- Placed iron rod N. 45° W. 34.73'



Signed by Allen H. McMachen
 Surveyor's Michigan License No. 16935

Date 12/11/97