

FEB 8 1999

SECTION

LAND CORNER RECORDATION CERTIFICATE

Filing Requirement of Act 74, Mich. P.A. 1970

For corners in PRAIRIE RONDE TWP  
KALAMAZOO (County)

Located in:

Corner Code #

1. Public Land Survey	T	4S.	R	12W.	I-3
	T		R		
	T		R		
	T		R		
2. Property Controlling in Section	S	T	R		
	S	T	R		
3. Miscellaneous Property in Section	S	T	R		
	S	T	R		

- 4. Lot No. \_\_\_\_\_, Recorded Plat \_\_\_\_\_
- 5. Private Claims \_\_\_\_\_
- 6. IWM Job No. 30465-97

I, Allen H. McMachen, in a field survey on September 29, 1997, do hereby certify that under requirements of P.A. 74, Michigan P.A. of 1970, the corner points mentioned in lines 1 and 2 above were in conformance with regulations and rules therefore as required in the current manual of survey instructions of the United States Department of the Interior, Bureau of Land Management or by a decree of a Court of Law and/or that the corner points mentioned in lines 3, 4 and 5 above were in conformance with the rules of the Michigan Board of Professional Surveyors or by a Decree of a Court of Law; established, re-established, monumented, re-monumented, recovered, found as expressed below:

**NOTE: Not more than 4 corners, all in the same town and range, may be recorded on this certificate.**

A. Description of original monument and accessories and/or subsequent restoration:

1829 - E.H. Lytle, D.S., Set post corner to Secs. 2, 3, 10 & 11 in Prairie, B. Oak 18" N. 75 1/2° E. 309 lks., B. Oak 24" N. 42° W. 576 lks..  
1873 - Ed Strong, C.S., "Stone by Hodgman left" Stone at S 1/4 corner Sec. 3 is on bisection

1874 - F. Hodgman, Surveyor (resetting N.E. cor., Sec. 3) prolonged Line 3-6 (S.E. cor. - E 1/4 cor.) and found stake. Set stake and stone and marked Y. Oak 24" N. 80° E. 143 lks., Y. Oak 10" S. 54 3/4° E. 86 lks., Texas corner stone is 1.24 ch. East.  
1874 - F. Hodgman, Surveyor, "Stone."  
No Date - K.C.R.C. placed iron rod near S.W. corner, Sec. 2 for road alignment in centerline - centerline.

B. Description of corner evidence found and/or method applied in restoring or reestablishing corner:

Found iron rod in mon. box, removed iron and box and excavated to depth of 5 feet finding no additional evidence of corner. Determined found iron rod was iron placed by Kalamazoo County Road Commission. Developed second search area by measuring 2630.37 feet between the Southwest corner of Section 3 (Harrison Monument over stone) and the South quarter corner, Section 3 (found stone) and extending said line Easterly from said South quarter corner 2630.37 feet (a good occupation line [fence] was existing 1316 feet East of South quarter corner, Sec. 3). Position developed is 0.9 feet West of a line produced Southerly between the Northwest corner, Section 2 (standard marker) and the West quarter corner, Section 2 (standard marker). Distance between said West quarter corner and search location is 2660.72 feet. Dug extensively at search area to depth of 4 feet (into virgin soil) and found no evidence of corner.

C. Description of monument for corner and accessories established to perpetuate locating the position of the corner:

Placed 30" Harrison Monument and Monument box at center of search area as above described, being 2660.72 feet South of West quarter corner, Sec. 2 and 2630.37 feet East of South quarter corner, Section 3. Harrison Monument is accepted as the best available evidence of the position of the original corner, Accessories:

- Nail & Tab in SW side of U. Pole N. 55° W. 36.18'
- Nail & Tab in SE side of U. Pole N. 70° E. 67.85'
- Nail & Tab in SW side of U. Pole S. 40° E. 54.74'
- Nail & Tab in SE side of U. Pole S. 40° W. 42.89'
- Iron in monument box is 7.3' East and 2.3' South


Signed by Allen H. McMachen

Date 12/15/98

Surveyor's Michigan License No. 16935

LIBER 2 PAGE 392  
 STATE OF MICHIGAN  
 COUNTY OF KALAMAZOO  
 RECEIVED FOR RECORD  
 '98 DEC 15 PM 3 50  
 Clerk - Register  
*Annally Johnson*

Register of Deeds Stamp & File Number

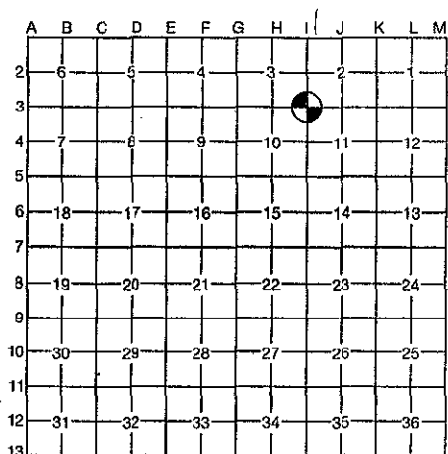

RATIFIED  
 BY KALAMAZOO COUNTY  
 REMONUMENTATION  
 PEER GROUP  
 12-18-1997

