

LAND CORNER RECORDATION CERTIFICATE
Filing Requirement of Act 74, Mich. P.A. 1970

STATE OF MICHIGAN
COUNTY OF KALAMAZOO
RECEIVED FOR RECORD

'98 OCT 20 AM 11 25

Smith Johnson

CLERK - REGISTER

LIBER 2 PAGE 336


Register of Deeds Stamp & File Number

<u>KALAMAZOO</u> (County)	Located In:	Corner Code #
1. Public Land Survey	T <u>4S</u> R <u>12W</u>	<u>J-7</u>
	T ___ R ___	_____
	T ___ R ___	_____
	T ___ R ___	_____
2. Property Controlling in Section	S ___ T ___ R ___	_____
	S ___ T ___ R ___	_____
3. Miscellaneous Property in Sec.	S ___ T ___ R ___	_____
	S ___ T ___ R ___	_____

4. Lot No. _____, Recorded Plat
5. Private Claims

I, WILLIAM K. CRANE, P.S., in a field survey on OCTOBER, 19 97 do hereby state that under requirements of P.A. 74, Michigan P.A. of 1970, the corner points mentioned in lines 1 and 2 above were in conformance with regulations and rules therefore as required in the current manual of survey instructions of the United States Department of the Interior, Bureau of Land Management or by a decree of a Court of Law and /or that the corner points mentioned in lines 3, 4 and 5 above were in conformance with the rules of the Michigan Board of Land Surveyors or by a Decree of a Court of Law; established, re-established, monumented, recovered, found as expressed below:

NOTE: Not more than 2 corners, all in the same town and range, may be recorded on this certificate.

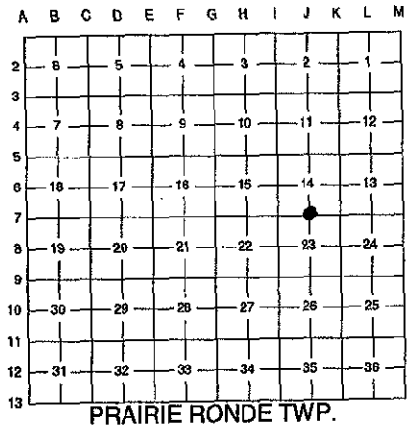

A. Description of original monument and accessories and/or subsequent restoration:

G.L.O.:
RAISED MOUND

V1:284 MAY 1873, BY E. STRONG, C.S.
STONE AT CENTER OF SECTION LINE

B. Description of corner evidence found and/or method applied in restoring or reestablishing corner:

FOUND 1/2" IRON AT SURFACE OF ROAD. DUG APPROXIMATELY 2.5 FEET AND FOUND IRON TO BE SET OVER LARGE STONE WITH 3" FLAT TOP. SET HARRISON MARKER AND MONUMENT BOX OVER STONE.

SURVEY &
REMONUMENTATION

NOV 25 1998


SECTION

RATIFIED
BY KALAMAZOO COUNTY
REMONUMENTATION
PEER GROUP
7-16-1998

C. Description of monument for corner and accessories established to perpetuate locating the position of the corner:

FOUND STONE IS ACCEPTED AS A CAREFUL AND FAITHFUL PERPETUATION OF THE POSITION OF THE ORIGINAL CORNER. RAISED STONE WITH HARRISON MARKER AND MONUMENT BOX.

FOUND NAIL & SPOTTER IN S.E. SIDE OF U.P, N.07°E, 37.19'
FOUND NAIL & SPOTTER IN E. SIDE OF U.P, N. 62°W, 69.88'
FOUND NAIL & SPOTTER IN S.E. SIDE OF U.P, S.62°W, 69.12'
SET NAIL IN N. SIDE OF U.P, S.81°E, 232.01'
IN CENTERLINE OF EASTWEST ROAD.

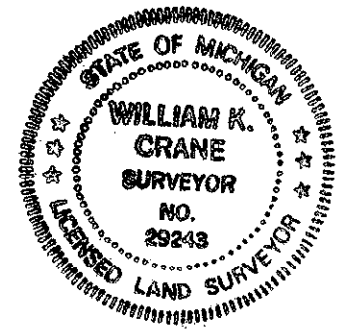

Signed by William K. Crane
William K. Crane, P.S.

Date 10/19/98

Surveyor's Michigan License No.: 29243