

LC-000083  
Page: 1 of 1  
12/17/1999 02:03P  
Bk-2 Pg-536

**LAND CORNER RECORDATION CERTIFICATE**  
Filing Requirement of Act 74, Mich. P.A. 1970

For corners in Prairie Ronde Twp.

Kalamazoo (County) Located in: Corner Code #

This corner common with A-12 Sec. 31, Schoolcraft

1. Public Land Survey T 4 S R 12 W M-12  
T R  
T R  
T R

2. Property Controlling S T R  
in Section S T R

3. Miscellaneous S T R  
Property in Sec. S T R

4. Lot No. \_\_\_\_\_, Recorded Plat \_\_\_\_\_

5. Private Claims \_\_\_\_\_

**SURVEY & REMONUMENTATION**


**FEB 08 2000**

**SECTION**

Register of Deeds Stamp & File Number

I, Robert E. Snell, in a field survey on Nov. 23, 1999 do hereby state that under requirements of P.A. 74, Michigan P.A. of 1970, the corner points mentioned in lines 1 and 2 above were in conformance with regulations and rules therefore as required in the current manual of survey instructions of the United States Department of the Interior, Bureau of Land Management or by a decree of a Court of Law and/or Board of Land Surveyors or by a Decree of a Court of Law, established, re-established, monumented, recovered, found as expressed below:

NOTE: Not more than 2 corners, all in the same town and range, may be recorded on this certificate.

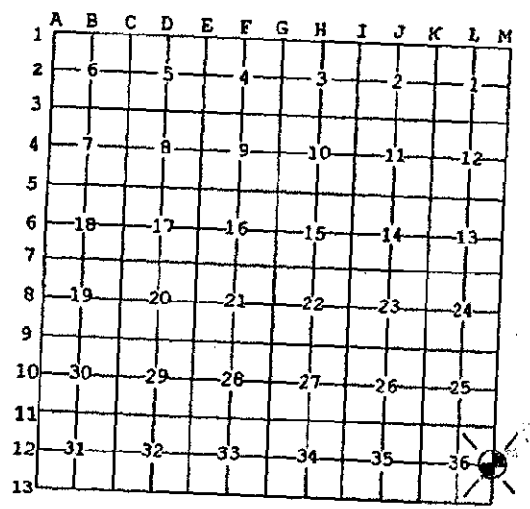

**A. Description of original monument and accessories and/or subsequent restoration:**

- 1825: United States Government Surveyors, J. Mullett; on East boundary of Section 36, T. 4 S., R. 12 W., Prairie Ronde Township. Set 1/4 Section post in prairie and raised mound.
- 1826: United States Government Surveyors, R. Clark; entered West boundary at post. (Northwest corner Section 31, T. 4 S., R. 11 W.). Note: No Jog.

**B. Description of corner evidence found and/or method applied in restoring or reestablishing corner:**

- 1869: F. Hodgman, County Surveyor; 1/4 Section corner. "Lost and re-established by bisecting the Section line F-G (Northeast corner - Southeast corner) set a stone with two smaller stones, two brick bats and some broken crockery at the corner.
- 1872: S. Hodgman, Deputy County Surveyor; Noted: stone in road - no other information.
- 1999: Set PK Nail on bisection of town line 1/2 way between Southwest corner Section 31 and Northwest corner Section 31, Schoolcraft. Dug a hole 8" in diameter and 24" deep. Noted brick on Southwest side of hole, enlarged hole and found large stone (18" x 8" x 10") with crockery around, 12" below surface of "XY" Avenue. Stone is 0.83' South and 0.58' West of true bisection.

**C. Description of monument for corner and accessories established to perpetuate locating the position of the corner:**

M-12: East 1/4 post, Section 36, T. 4 S., R. 12 W., ratified by the Kalamazoo County Remonumentation Program Peer Group on December 9, 1999 and is accepted as a careful and faithful re-establishment of the position of the original corner. Found stone (18" x 8" x 10") with brick and crockery. Stone set in 1869 by F. Hodgman, County Surveyor. Placed 10" of Harrison monument in concrete in monument box over stone.

Center line	Telephone Pedestal	S. 27°-32' W.	30.52'
Center line	Telephone Pedestal	S. 80°-47' E.	184.94'
Center line	Fiber-Optic Post	S. 31°-05' W.	32.81'
Center of Iron	with Red Cap (on Town Line)	N. 00°-04' E.	15.01'
Center of Iron	with Red Cap (Traverse Point)	S. 28°-16' E.	17.96'

Signed by Robert E. Snell  
Surveyor's Michigan License No. 9734

Date 12/16/99

**RATIFIED**  
**BY KALAMAZOO COUNTY**  
**REMONUMENTATION**  
**PEER GROUP**  
12/9/99