

NOV 21 1997

COMMISSION

LAND CORNER RECORDATION CERTIFICATE

Filing Requirement of Act 74, Mich. P.A. 1970

RECORDED LAKE COUNTY, MI.

LIBER 004 PAGE 0027

SEP 12 10 30 AM '97

REGISTER OF DEEDS

Register of Deeds Stamp & File Number

For corners in

Lake (County)

Located In:

Corner Code #

1. Public Land Survey

T 17N R 12W
T 17N R 11W

M-3

A-3

2. Property Controlling in Section

S T R

3. Miscellaneous Property in Sec.

S T R

4. Lot No. , Recorded Plat

5. Private Claims

Robert L. Wetherell

February 20, 19 97

Grid with columns A-M and rows 2-13. Contains numbers 1-36.

I do hereby certify that under requirements of P.A. 74, Michigan P.A. of 1970, the corner points mentioned in lines 1 and 2 above were in conformance with regulations and rules therefore as required in the current manual of survey instructions of the United States Department of the Interior, Bureau of Land Management or by a decree of a Court of Law and/or that the corner points mentioned in lines 3, 4 and 5 above were in conformance with the rules of the Michigan Board of Land Surveyors or by a Decree of a Court of Law; established, re-established, monumented, re-monumented, recovered, found as expressed below:

NOTE: Not more than 4 corners, all in the same town and range, may be recorded on this certificate.

Description of original monument and accessories and/or subsequent restoration:

M-3; A-3 - Section corner common to Sec. 1, T17N, R12W and Sec. 6, T17N, R11W, Lake Co., Mi.

1837 - John Hodgson, G.L.O.

Undated - Co. Surveyor Records

1973 - Clinton E. Cole, LS 17615

#1 - 7" Pine S68°W 5 Links

#5 - 9" B. Oak N19°E 101.5'

Same as Blass from 1970

#2 - 7" Pine N31°W 16 Links

1970 - George Blass, LS 5489

1976 - Robert Griffin, LS 13584

1916 - George Johnson, Co. Sur.

"T" Iron

Found Monument by Blass

Found Old Stake

#6 - 8" W. Pine S72°W 49.85'

Set 5" x 36" Concrete Monument

#3 - 8" W. Oak S58°E 40.7'

#7 - 30" B. Oak N50°W 122.15'

#6 - 8" W. Pine S72°W 49.85'

#4 - 7" W. Oak S66°W 62.8'

#8 - N.W. Leg of Tower S48°E 49.65'

#7 - 30" B. Oak N50°W 122.15'

#8 - N.W. Leg Tower S48°E 49.65'

#9 - 4" x 7' Post West 33.13'

Description of corner evidence found and/or method applied in restoring or reestablishing corner:

M-3; A-3 - Section corner common to Sec. 1, T17N, R12W and Sec. 6, T17N, R11W, Lake Co., Mi.

I found U.S.F.S. Concrete Monument 10 feet East of the centerline of North and South dirt road and in centerline of old road bed to East.

Condition of the accessories are as follows: #1 Gone, #2 Gone, #3 Gone, #4 Found in good condition, #5 Gone, #6 Found in good condition, #7 Found Stump; #8 Found in good condition, #9 Found in poor condition.


RATIFIED BY THE LAKE CO. PEER REVIEW GROUP IN ACCORDANCE WITH P.A. 345 CHAIRMAN R. L. W. DATE 8-27-97

Description of monument for corner and accessories established to perpetuate locating the position of the corner:

M-3; A-3 - Section corner common to Sec. 1, T17N, R12W and Sec. 6, T17N, R11W, Lake Co., Mi.

I accepted the U.S.F.S. Concrete Monument as a substantial marker for the corner, and is accepted as a careful and faithful re-establishment of the position of the original corner.

- 8" W. Oak N40°W 132.29' (60d spike in S.W. side)
18" W. Oak N69°E 113.90' (60d spike in N. side)
N.W. Leg of Tower S40°E 49.63' (O.B.T. #8)
14" W. Oak S52°W 80.77' (60d spike in S.E. side)
12" W. Pine S78°W 49.87' (60d spike in S. side) #6
18" W. Oak S68°W 64' #4

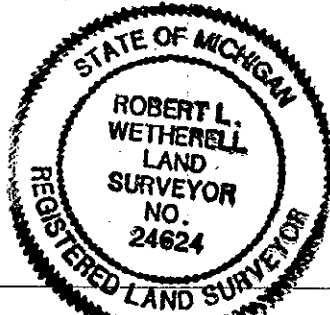

Signed by Robert L. Wetherell

Date 8-27-97

Surveyor's Michigan License No. 24624