

JAN 12 1996

COMMISSION

LAND CORNER RECORDATION CERTIFICATE  
Filing Requirement of Act 74, Mich. P.A. 1970

LIBER 003 PAGE 0302

For corners in

Lake _____ (County)	Located In:	Corner Code #/1
Public Land Survey	T 17N R 11W A-10 ✓	
	T 17N R 12W M-10	
	T _____ R _____	
	T _____ R _____	
Property Controlling in Section	S _____ T _____ R _____	
Miscellaneous Property in Sec.	S _____ T _____ R _____	

RECORDED  
LAKE COUNTY, MI.  
SEP 5 3 04 PM '95  
REGISTER OF DEEDS  
*Shirley H. Peterson*

Register of Deeds Stamp & File Number

Lot No. \_\_\_\_\_, Recorded Plat \_\_\_\_\_  
Private Claims \_\_\_\_\_

A	B	C	D	E	F	G	H	I	J	K	L	M
2	6	5	4	3	2	1						
3												
4	7	8	9	10	11	12						
5												
6	18	17	16	15	14	13						
7												
8	19	20	21	22	23	24						
9												
10	30	29	28	27	26	25						
11												
12	31	32	33	34	35	36						
13												


Robert L. Wetherell, in a field survey on August 21, 1995, do hereby certify that under requirements of P.A. 74, Michigan P.A. of 1970, the corner points mentioned in lines 1 and 2 above were in conformance with regulations and rules therefore as required in the current manual of survey instructions of the United States Department of the Interior, Bureau of Land Management or by a decree of a Court of Law and/or that the corner points mentioned in lines 3, 4 and 5 above were in conformance with the rules of the Michigan Board of Land Surveyors or by a Decree of a Court of Law; established, re-established, monumented, re-monumented, recovered, found as expressed below:

NOTE: Not more than 4 corners, all in the same town and range, may be recorded on this certificate.

A. Description of original monument and accessories and/or subsequent restoration:  
A-10 & M-10 - 1/4 corner common to Section 30, T17N, R11W AND Section 25, T17N, R12W, Lake Co., Mi.  
1837 - John Hodgson, G.L.O. 1973 - Clinton E. Cole, LS 17615 1976 - Robert A. Griffin, LS 13584  
#1 - 22" Pine S52°W 8 Links Survey recorded in Liber 01, Pg. 233 Replaced 1" Iron Pipe with 5" x 60" Concrete Monument.  
#2 - 14" Pine N47°W 10 Links Found 1" Iron Pipe L.C.R.C. - Liber 02, Pg. 183.  
1916 - George Johnson, Co. Surveyor #5 - 6" Maple N70°W 61.43' #5 - 6" Maple N70°W 61.43'  
1" Gas Pipe #6 - 10" W. Oak S54°W 66.12' #6 - 10" W. Oak S54°W 66.12'  
#3 - 5" W. Oak N49°E 30' #7 - 7" R. Oak S62°E 117.98' #7 - 7" R. Oak S62°E 117.98'  
#4 - 6" B. Oak N20°W 32.5' #8 - 1/2" Re-bar N45°E 46.72' #8 - 1/2" Re-bar N45°E 46.72'

B. Description of corner evidence found and/or method applied in restoring or reestablishing corner:  
A-10 & M-10 - 1/4 corner common to Section 30, T17N, R11W AND Section 25, T17N, R12W, Lake Co., Mi.  
I found 5" Concrete Monument 6 feet more or less North of East and West dirt road and 5 feet West of North and South dirt road. I found accessories 5 thru 8 in good condition. I did not recover accessories 1 thru 4 inclusive.

C. Description of monument for corner and accessories established to perpetuate locating the position of the corner:  
A-10 & M-10 - 1/4 corner common to Section 30, T17N, R11W AND Section 25, T17N, R12W, Lake Co., Mi.  
I accepted the 5" Concrete Monument, as a substantial monument for the corner, and is accepted as a corner for the re-establishment of the position of the original corner.  
8" Maple N64°W 61.43' (60d spike in N. side) #5  
12" W. Oak S54°W 66.12" (60d spike in N. side) #6  
11" R. Oak S62°E 118.07' (60d spike in S. side) #7  
S.W. Leg of steel tower N14°E 177.92'

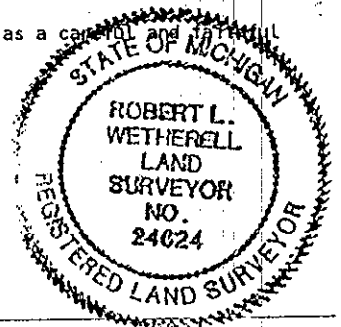

Signed by *Robert L. Wetherell* Date August 29, 1995  

Surveyor's Michigan License No. \_\_\_\_\_  
PATIFIED BY THE LAKE CO. PEER REVIEW GROUP  
IN ACCORDANCE WITH P.A. 345  
CHAIRMAN *R.L.W.*  
DATE 8-29-95