

NOV 21 1997

COMMISSION

LAND CORNER RECORDATION CERTIFICATE
Filing Requirement of Act 74, Mich. P.A. 1970

RECORDED LAKE COUNTY, MI. LIBER 004 PAGE 0030 SEP 12 10 30 AM '97

REGISTER OF DEEDS

For corners in

Table with columns: Lake (County), Located In: (17N, 11W), Corner Code # (6-5). Rows include Public Land Survey, Property Controlling in Section, and Miscellaneous Property in Sec.

Register of Deeds Stamp & File Number


4. Lot No. , Recorded Plat
5. Private Claims

Robert L. Wetherell, in a field survey on April 2, 1997 do hereby certify that under requirements of P.A. 74, Michigan P.A. of 1970, the corner points mentioned in lines 1 and 2 above were in conformance with regulations and rules therefore as required in the current manual of survey instructions of the United States Department of the Interior, Bureau of Land Management or by a decree of a Court of Law and/or that the corner points mentioned in lines 3, 4 and 5 above were in conformance with the rules of the Michigan Board of Land Surveyors or by a Decree of a Court of Law; established, re-established, monumented, re-monumented, recovered, found as expressed below:

NOTE: Not more than 4 corners, all in the same town and range, may be recorded on this certificate.

A. Description of original monument and accessories and/or subsequent restoration:

Table listing survey details: 1838 - John Hodson, G.L.O.; 1952 - George Blass, LS 5489; 1983 - C. Cole, LS 17615; 1983 - R. Wetherell, LS 24624. Includes descriptions of monuments like Beech trees, pipes, poles, and bench marks.

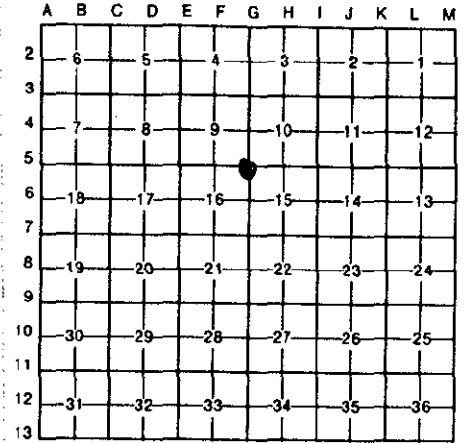

B. Description of corner evidence found and/or method applied in restoring or reestablishing corner:


M-4 - W. 1/4 Corner Sec. 12, T17N, R12W, Yates Twp., Lake Co., Mi. I found a 1/2" re-bar at road surface in centerline of East and West road and 4 feet West of North and South road. Directly under 1/2" re-bar, at a depth of 3 feet, I found a 3/4" pipe with stones and rotted wood stake. Condition of the accessories are as follows: #1 Gone #2 Gone, #3 Gone #4 Gone, #5 Found in good condition, #6 Found in good condition, #7 Found in good condition, #8 Found in good condition.

RATIFIED BY THE LAKE CO. PEER REVIEW GROUP IN ACCORDANCE WITH P.A. 345

CHAIRMAN R.L.W. DATE 8-27-97

C. Description of monument for corner and accessories established to perpetuate locating the position of the corner:

M-4 - W. 1/4 Corner Sec. 12, T17N, R12W, Yates Twp., Lake Co., Mi. I set a 3/4" x 24" re-bar with Lake County Brass Cap directly over the 3/4" pipe, and is accepted as a careful and faithful re-establishment of the position of the original corner. U.S.G.S. Monument S57°W 44.92', 32" Maple N19°E 128.99' (60d spike in W. side) #8, 12" W. Pine S36°W 85.98' (60d spike in W. side), P.Pole (new) S60°W 80.29' (P.K. Nail in N.W. side), P.Pole S25°E 55.89' (Nail in W. side)

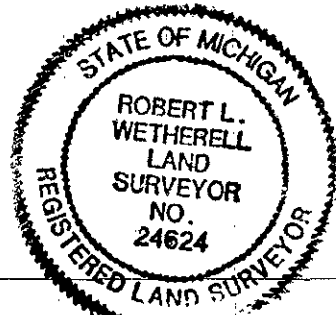

signed by Robert L. Wetherell Date 8-27-97

Surveyor's Michigan License No. 24624