

JAN 25 2001

SECTION

LAND CORNER RECORDATION CERTIFICATE

FILING REQUIREMENT OF ACT 74, Mich. P.A. 1970

For corners in Lake _____	Located in:	Corner Code#
1. Public Land Survey	T 17 N R 11 W	I-4
	T _____ R _____	_____
	T _____ R _____	_____
	T _____ R _____	_____
2. Property Controlling in Section	S T R	_____
	S T R	_____
3. Miscellaneous Property in Sec.	S T R	_____
	S T R	_____
4. Lot No. _____ Recorded Plat _____		
5. Private Claims _____		

RECORDED  
LAKE COUNTY, MI  
LIBER 004 PAGE 0246  
MAY 5 10 26 AM '00  
*Shirley Meyers*  
REGISTER OF DEEDS  
Register of Deeds Stamp & File Number

	A	B	C	D	E	F	G	H	I	J	K	L	M
1													
2	6	5	4	3	2	1							
3													
4	7	8	9	10	11	12							
5													
6	18	17	16	15	14	13							
7													
8	19	20	21	22	23	24							
9													
10	30	29	28	27	26	25							
11													
12	31	32	33	34	35	36							
13													

I, Robert L. Wetherell, in a field survey on March 13, 2000, do hereby certify that under requirements of P.A. 74, Michigan P.A. of 1970, the corner points mentioned in lines 1 and 2 above were in conformance with regulations and rules therefore as required in the current manual of survey instructions of the United States Department of the Interior, Bureau of Land Management or by decree of a Court of Law and/or that the corner points mentioned in lines 3, 4, and 5 above were in conformance with the rules of the Michigan Board of Land Surveyors or by a Decree Of a Court of Law, established, re-established, monumented, re-monumented, recovered, found as expressed below:

**I-4 - 1/4 Corner common to Sections 10 & 11, T17N, R11W**

**A. Description of original monument and accessories and/or subsequent restoration:**

- |                                  |                               |  |
|----------------------------------|-------------------------------|--|
| <b>1838 - J. Hodgson, G.L.O.</b> | <b>1975 C. Cole, LS 17615</b> | <b>1983 - J. Erickson, LS 16929</b>            |
| #1 - 8" Beech N65°E 34 Links     | L.C.R.C. - L. 02, Pg. 328     | Same witnesses as Cole's in 1975.              |
| #2 - 10" Beech N24°W 17 Links    | Set 1/2" rebar                |  |
|                                  | #3 - Fence post N87°W 31.64'  | <b>1990 thru 1999 - R. Wetherell, LS 24624</b> |
|                                  | #4 - 42" Maple N34°E 90.38'   | Numerous surveys with same witnesses           |
|                                  | #5 - 34" Ash S46°E 65.60'     | as Cole's in 1975.                             |
|                                  | #6 - 18" Walnut S30°E 81.20'  |  |

**B. Description of corner evidence found and/or method applied in restoring of reestablishing corner:**

I found a 1/2" Capped Iron (LS 14102) by J. Wilcox in a monument box in the centerline of a North and South road. Wilcox surveyed for new road construction in 1995 more or less. The recovered accessories fit this found corner.


Condition of the accessories are as follows: #1 Gone, #2 Gone, #3 Gone, #4 Found in poor condition #5 Found in good condition, #6 Found in good condition.

**C. Description of monument for corner and accessories established to perpetuate locating the position of the corner:**

I accepted the 1/2" capped iron in the monument box as a substantial monument for the corner, and is accepted as a careful and faithful reestablishment of the position of the original corner.

- 16" Walnut S27°E 94.03' (nail in N.E. side)
- 21" Walnut S34°E 81.15' (60d spike in S.W. side) #6
- Railroad Beam Fence Post N78°W 34.05' (60d spike in N. side)
- P. Pole N5°W 225.38' (P.K. nail in E. side)
- 10" Ash N27°E 119.04' (60d spike in W. side)

*R.L.W.*  
4-11-2000

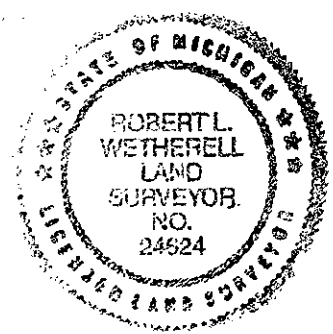

Signed by Robert L. Wetherell  
Surveyor's Michigan License No. 24624

Date April 12, 2000